


WELL PLUGGING RECORD

Give All Information Completely
Make Required Affidavit
Mail or Deliver Report to:
Conservation Division
State Corporation Commission
800 Biting Building
Wichita, Kansas

PAWNEE County. Sec. 19 Twp. 23 Rge. (E) 16 (W)
Location as "NE/CNW $\frac{1}{4}$ SW $\frac{1}{4}$ " or footage from lines NE NE SE
Lease Owner ROCKET DRILLING COMPANY, ETAL
Lease Name ANNA THOMAS Well No. 1
Office Address 352 NORTH BROADWAY, WICHITA 2, KANSAS
Character of Well (completed as Oil, Gas or Dry Hole) DRY HOLE
Date well completed AUGUST 31, 1951
Application for plugging filed AUGUST 31, 1951
Application for plugging approved SEPTEMBER 4, 1951
Plugging commenced AUGUST 31, 1951
Plugging completed AUGUST 31, 1951
Reason for abandonment of well or producing formation DRY

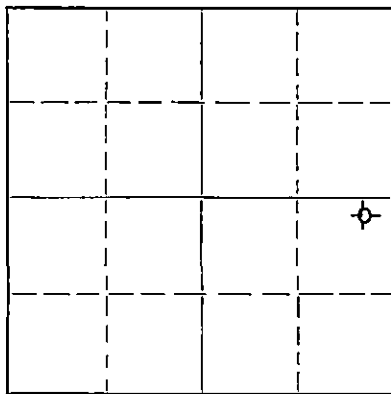

Locate well correctly on above Section Plat

If a producing well is abandoned, date of last production 19...
Was permission obtained from the Conservation Division or its agents before plugging was commenced? YES - IN FIELD FROM C. C. STOUGH

Name of Conservation Agent who supervised plugging of this well C. C. STOUGH
Producing formation ARBUCKLE Depth to top 4312 Bottom 4343 Total Depth of Well 4343 Feet
Show depth and thickness of all water, oil and gas formations.

OIL, GAS OR WATER RECORDS

CASING RECORD

Formation	Content	From	To	Size	Put In	Pulled Out
SOIL, SAND, SHALE & SHELLS	WATER	0	701	8-5/8"	701'	NONE

Describe in detail the manner in which the well was plugged, indicating where the mud fluid was placed and the method or methods used in introducing it into the hole. If cement or other plugs were used, state the character of same and depth placed, from feet to feet for each plug set.

FILLED HOLE WITH HEAVY MUD 4343 TO 250
CEMENT PLUG - 15 SAX CEMENT 250 TO 210
HEAVY MUD 210 TO 40
CEMENT - 10 SAX 40 TO 6
SOIL 6 TO 0

RECEIVED
STATE CORPORATION COMMISSION
SEP 8 X 1951
CONSERVATION DIVISION
Wichita, Kansas
9-8-51

(If additional description is necessary, use BACK of this sheet)

Correspondence regarding this well should be addressed to ROCKET DRILLING COMPANY
Address 352 NORTH BROADWAY, WICHITA 2, KANSAS

STATE OF KANSAS, COUNTY OF SEDGWICK, ss.
L. L. COTTER, JR. (employee of owner) or (owner or operator) of the above-described well,
being first duly sworn on oath, says: That I have knowledge of the facts, statements, and matters herein contained and the log of the above-described well as filed and that the same are true and correct. So help me God.
(Signature) BY Rocket Drilling Company
352 NORTH BROADWAY, WICHITA 2, KANSAS (Address)

SUBSCRIBED AND SWORN to before me this 6TH day of SEPTEMBER, 1951.

Amel Fisk
Notary Public.

My commission expires 7-19-54

PLUGGING
FILE SEC-19-T-23-R-160
BOOK PAGE 107 LINE 21

ROCKET DRILLING COMPANY
 352 NORTH BROADWAY
 WICHITA 2, KANSAS

15-145-00154-0000

A. R. WOOD, DISBURSEMENT AGENT
 BEACON BUILDING
 WICHITA 2, KANSAS

ANNA THOMAS #1
 NE NE SE, 19-23-16W
 PAWNEE COUNTY, KANSAS

ELEVATION: 2066 D.F. 2064 GR.
 SPUDDED: AUGUST 14, 1951
 ROTARY COMPLETED: AUGUST 31, 1951
 CABLE TOOLS COMPLETED: NONE
 INITIAL PRODUCTION: DRY & ABANDONED
 CONTRACTOR: ROCKET DRILLING COMPANY

CASING RECORD

701' 8-5/8" 24# SEAMLESS CASING CEMENTED W/350 SACKS CEMENT.
 5-1/2" NONE

DRILLERS LOG

SOIL, SAND & SHALE	0 TO 50	LIME & SHALE	2335 TO 2460
SHALE & SHELLS	450	SHALE & SHELLS	2530
SAND	465	LIME	2550
SHALE	530	SAND	2565
SAND	583	LIME	2725
SHALE	701	LIME & SHALE	3200
SHALE & SHELLS	1040	LIME	3974
ANHYDRITE	1065	LIME & SHALE	4080
SHALE & SHELLS	1460	LIME	4124
SHALE & SALT	1715	CHERT & LIME	4186
SHALE & SHELLS	1925	LIME	4197
LIME	2250	LIME & CHERT	4304
SHALE, LIME & SAND	2335	LIME & SHALE	4343

RECEIVED
 STATE CORPORATION COMMISSION

STATE OF KANSAS)
 SEDGWICK COUNTY) SS:

SEP 8 X 1951
 CONSERVATION DIVISION

I HEREBY CERTIFY THAT TO THE BEST OF MY KNOWLEDGE AND BELIEF, THE FOREGOING LOG IS TRUE AND CORRECT.

PLUGGING
 FILE SEC 19 T 23 R 1660
 BOOK PAGE 107 LINE 21

ROCKET DRILLING COMPANY
 BY M. A. Davis

SUBSCRIBED AND SWORN TO BEFORE ME, A NOTARY PUBLIC, IN AND FOR THE STATE AND COUNTY AFORESAID THIS 5TH DAY OF SEPTEMBER, 1951.

MY COMMISSION EXPIRES: JULY 19, 1954

Harriet J. Jirik
 NOTARY PUBLIC