

STATE OF KANSAS
STATE CORPORATION COMMISSION


WELL PLUGGING RECORD

15-145-20571-0001

Give All Information Completely
Make Required Affidavit
Mail or Deliver Report to
Conservation Division
State Corporation Comm.
245 North Water
Wichita, KS 67202

Pawnee County. Sec. 21 Twp. 23S Rge. 16W E/W
Location as "NE/CNW $\frac{1}{4}$ SW $\frac{1}{4}$ " or footage from lines
C SW NW

Lease Owner Zenith Drilling Corporation, Inc.
Lease Name Hawes #1 #B "C" Well No. 1 WD
Office Address Suite 600, 200 West Douglas, Wichita, Ks 67202
Character of Well (Completed as Oil, Gas or Dry Hole) _____

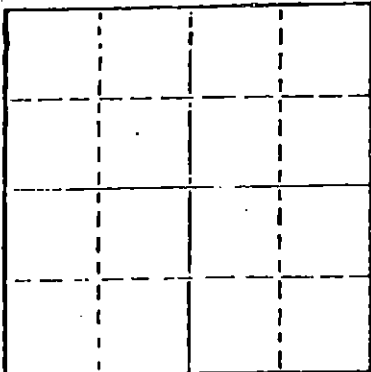

Locate well correctly on above
Section Plot

Dry Hole
Date Well completed August 4, 1979 19
Application for plugging filed August 3, 1979 19
Application for plugging approved August 3, 1979 19
Plugging commenced 11:30 PM, August 3, 1979 19
Plugging completed 12:30 AM, August 4, 1979 19
Reason for abandonment of well or producing formation _____

Dry Hole
If a producing well is abandoned, date of last production _____ 19

Was permission obtained from the Conservation Division or
its agents before plugging was commenced? Yes

Name of Conservation Agent who supervised plugging of this well Marion Schmidt
Producing formation _____ Depth to top _____ Bottom _____ Total Depth of Well 758'
Show depth and thickness of all water, oil and gas formations.

OIL, GAS OR WATER RECORDS

CASING RECORD

FORMATION	CONTENT	FROM	TO	SIZE	PUT IN	PULLED OUT
					None - Washdown	

Describe in detail the manner in which the well was plugged, indicating where the mud fluid was placed and the method or methods used in introducing it into the hold. If cement or other plugs were used, state the character of same and depth placed, from _____ feet to _____ feet for each plug set.

Filled hole with heavy mud.
60 sacks 50/50 Pozmix with 6% gel at 495';
30 sacks at 235'; 10 sacks, 1/4 sack hulls
and plug at 40'. 3 sacks in rathole.

8-17-79

RECEIVED
STATE CORPORATION COMMISSION

(If additional description is necessary, use BACK of this sheet) 979

Name of Plugging Contractor Sterling Drilling Company, P. O. Box 129, Sterling, Kansas 67579

STATE OF KANSAS COUNTY OF RICE, ss.
F. A. Wuellner (employee of owner) or (owner or operator)
of the above-described well, being first duly sworn on oath, says: That I have knowledge of the facts, statements, and matters herein contained and the log of the above-described well as filed and that the same are true and correct. So help me God.

(Signature) F. A. Wuellner
STERLING DRILLING COMPANY
F. A. Wuellner, Secretary
P. O. Box 129, Sterling, Kansas 67579
(Address)

SUBSCRIBED AND SWORN TO before me this 8th day of August, 19 79.



Charles M. Hall
Charles M. Hall, Notary Public.

My commission expires _____

STERLING DRILLING COMPANY
P. O. Box 129
Sterling, Kansas 67579

15-45-26571-0001

WELL LOG ----- HAMES #1 TD
Located: C SW NW, Section 21-23S-16W, Pawnee County, Kansas

OWNER: Zenith Drilling Corporation, Inc.
ROTARY DRILLING CONTRACTOR: Sterling Drilling Company

COMMENCED: August 3, 1979
COMPLETED: August 4, 1979

TOTAL DEPTH: 758'

LOG

0 - 347 Washdown
347 - 758 Red Bed

CASING RECORD

None
Plugged with 60 sacks 50/50 Pozmix with 6%
gel at 495'; 30 sacks at 235'; 10 sacks,
1/4 sack hulls and plug at 40'. 3 sacks
in rathole. Plug down at 12:30 AM,
8-4-79, by Halliburton.

RECEIVED
STATE CORPORATION COMMISSION

AUG 17 1979

CONSERVATION DIVISION
Topeka, Kansas