

15-145-06059-0000

STATE OF KANSAS
STATE CORPORATION COMMISSION

WELL PLUGGING RECORD

Give All Information Completely
Make Required Affidavit
Mail or Deliver Report to:
Conservation Division
State Corporation Commission
800 Westing Building
Wichita, Kansas

Pawnee County. Sec. 22 Twp. 23 Rge. 16 (W)

Location as "NE/CNW*SW*" or footage from lines. SW SW NE

Lease Owner T. H. Mastin

Lease Name Yeager Well No. 1

Office Address 4638 J. C. Nichols Pkwy., Kansas City, Missouri

Character of Well (completed as Oil, Gas or Dry Hole) Dry Hole

Date well completed November 26, 1953 19

Application for plugging filed November 26, 1953 19

Application for plugging approved November 26, 1953 19


Plugging commenced November 26, 1953 19

Plugging completed November 26, 1953 19

Reason for abandonment of well or producing formation Dry Hole

If a producing well is abandoned, date of last production 19

Was permission obtained from the Conservation Division or its agents before plugging was commenced? Yes

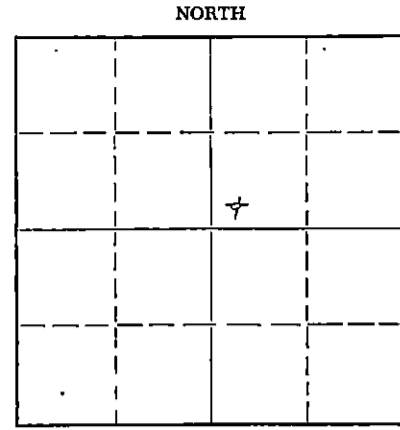

Locate well correctly on above Section Plat

Name of Conservation Agent who supervised plugging of this well M. A. Rives

Producing formation Depth to top Bottom Total Depth of Well 4146 Feet

Show depth and thickness of all water, oil and gas formations.

OIL, GAS OR WATER RECORDS

CASING RECORD

FORMATION	CONTENT	FROM	TO	SIZE	PUT IN	PULLED OUT
	Surface Pipe	0	312	8-5/8"	312	None

Describe in detail the manner in which the well was plugged, indicating where the mud fluid was placed and the method or methods used in introducing it into the hole. If cement or other plugs were used, state the character of same and depth placed, from feet to feet for each plug set.

Filled hole with heavy mud to 300'. Set plug at 300', run 20 sacks cement. Filled hole with mud to 40'. Set plug at 40' and run 10 sacks cement.

12-1-53
CONSERVATION DIVISION
WICHITA, KANSAS

(If additional description is necessary, use BACK of this sheet)

Name of Plugging Contractor Tearn Drilling Company

Address Box 45, Ellinwood, Kansas.

STATE OF KANSAS, COUNTY OF BARTON, ss. I, W. F. Banks

(employee of owner) or (owner/operator) of the above-described well, being first duly sworn on oath, says: That I have knowledge of the facts, statements, and matters herein contained and the log of the above-described well as filed and that the same are true and correct. So help me God.

(Signature) W. F. Banks

Ellinwood, Kansas

(Address)

SUBSCRIBED AND SWORN TO before me this 27th day of November, 1953

George A. Meyer
Notary Public

My commission expires Feb. 10, 1955.

PLUGGING
FILE SEC 22 T 23 R 16W
BOOK PAGE 146 LINE 14

24-7386-5 3-53-20M

WELL LOG

15-45-00059-0000

T. H. MASTIN, OWNER - Yeager #1
SW/4 SW/4 NE/4 Section 22, Township 23, Range 16W,
Pawnee County, Kansas

Elevation: 2054 DF

Figures indicate bottom of formation
0 to 75 sand

Pipe Record:

8-5/8" set at 312'

TOPS: RBM

Hebner 3539
Brown Lims 3662
Lansing 3671
Base Kansas City 3933
Conglomerate 4048
Simpson Shale 4076
Arbuckle 4121

160 shale
350 shale & shells
505 Red Bed
570 sand
1012 shale & shells
1041 Anhydrite
1630 shale & shells
1820 salt
1995 shale & shells
3920 lime & shale
3995 lime
4050 lime & shale
4080 Conglomerate
4146 Arbuckle
4146 Total Depth

Rotary Commenced 11-13-53
Completed 11-26-53

STATE OF KANSAS)
COUNTY OF BARTON) SS

I, Warren O. Johnson, employee of the owner, being first duly sworn on oath, declare: That I have knowledge of the facts, statements and matters herein contained pertaining to the log of the above-described well, as filed, and that the same are true and correct.

REC
STATE CORP

Warren O. Johnson

Subscribed and Sworn to before me this 30th day of November, 1953.

CONSERVATIVE
Wichita

George A. Meyer

My commission expires Feb. 10, 1955.

PLUGGING
FILE SEC 22 T 23 R 16W
BOOK PAGE 146 LINE 14