


WELL PLUGGING RECORD

Give All Information Completely
Make Required Affidavit
Mail or Deliver Report to:
Conservation Division
State Corporation Commission
211 No. Broadway
Wichita, Kansas

NORTH

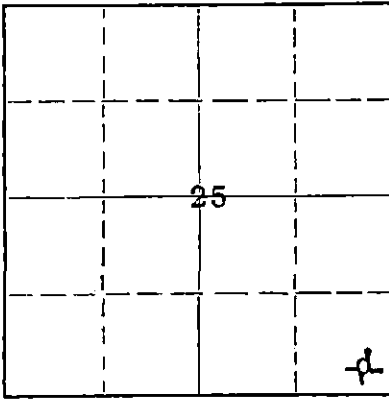

Locate well correctly on above
Section Plat

Pawnee County, Sec. 25 Twp 23S Rge. 16W (XX) (W)

Location as "NE/CNW%SW%" or footage from lines SE SE SE
Lease Owner D. R. Lauck Oil Company, Inc.
Lease Name Rutherford Well No. 1
Office Address 301 S. Broadway, Wichita, Kansas
Character of Well (completed as Oil, Gas or Dry Hole) Dry Hole
Date well completed May 21, 19 62
Application for plugging filed May 21, 19 62
Application for plugging approved May 21, 19 62
Plugging commenced May 21, 19 62
Plugging completed May 21, 19 62
Reason for abandonment of well or producing formation Dry Hole

If a producing well is abandoned, date of last production -- 19 --
Was permission obtained from the Conservation Division or its agents before plugging was commenced? Yes

Name of Conservation Agent who supervised plugging of this well _____
Producing formation _____ Depth to top _____ Bottom _____ Total Depth of Well 3718 Feet
Show depth and thickness of all water, oil and gas formations.

OIL, GAS OR WATER RECORDS

CASING RECORD

FORMATION	CONTENT	FROM	TO	SIZE	PUT IN	PULLED OUT
	8-5/8"	201'	6'	8-5/8"	201'	None

Describe in detail the manner in which the well was plugged, indicating where the mud fluid was placed and the method or methods used in introducing it into the hole. If cement or other plugs were used, state the character of same and depth placed, from _____ feet to _____ feet for each plug set.

3718-190' Mud
190-186' Plug
186- 35' 20 sacks Cement & Mud
35- 31' Plug
31- 6' 10 Sacks Cement (Bottom of Cellar)

RECEIVED
STATE CORPORATION COMMISSION
JUN 14 1962
CONSERVATION DIVISION
Wichita, Kansas

(If additional description is necessary, use BACK of this sheet)
Name of Plugging Contractor Sun Cementing Company
Address Great Bend, Kansas

STATE OF KANSAS COUNTY OF SEDGWICK, ss.
John H. Knightley (employee of owner) or (owner or operator) of the above-described well, being first duly sworn on oath, says: That I have knowledge of the facts, statements, and matters herein contained and the log of the above-described well as filed and that the same are true and correct. So help me God.

(Signature) John H. Knightley
301 S. Broadway, Wichita, Kansas
(Address)

SUBSCRIBED AND SWORN TO before me this 13th day of June, 19 62

My commission expires March 12, 1963

Stella J. Bodine
Notary Public.



15-145-19055-0000

D. R. Lauck Oil Company, Inc.

Rutherford #1

SE SE SE Sec. 25-23S-16W
Pawnee County, Kansas

Commenced: May 13, 1962

Completed: May 21, 1962

Casing Record: 201' 8-5/8" Cemented w/185 sacks Cement, 4 sacks
Calcium Chloride.

Elevation: GL 2040; DF 2042; KB 2044.

Drillers Log

Tops

Sand	80		Sample
Yellow Clay	145	Anhydrite	980/1064
Blue Shale	350	Base Anhydrite	1005/1039
Red Bed	470	Heebner	3537-1493
Sand	520	Toronto	3562-1518
Red Bed	980	Douglas	3577-1533
Anhydrite	1005	Brown Lime	3673-1629
Shale & Shells	1825	Lansing K.C.	3683-1639
Lime & Shale	1925	Total Depth	3718-1674
Lime	2065		
Shale & Lime	2150		
Lime & Shale	2450		
Lime	2580	D&A	
Shale & Lime	3135		
Lime	3325		
Lime, Some Chalky	3391		
Lime, Chalky, Broken & Sandy	3540		
Lime & Shale	3650		
Shale & Lime	3674		
Lime	3718	RTD	

RECEIVED
STATE CORPORATION COMMISSION
JUN 14 1962
CONSERVATION DIVISION
Wichita, Kansas