


Give All Information Completely
Make Required Affidavit
Mail or Deliver Report to:
Conservation Division
State Corporation Commission
211 No. Broadway
Wichita, Kansas

WELL PLUGGING RECORD

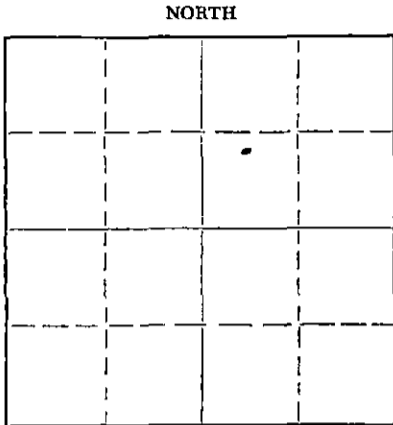

Locate well correctly on above
Section Plat

Barton County. Sec. 23 Twp. 16S Rge. xxx 12 (W)
Location as "NE/CNW/SW" or footage from lines C N/2 SW NE
Lease Owner Gulf Oil Corporation
Lease Name Minnie Well No. 4
Office Address Box 661, Tulsa, Oklahoma
Character of Well (completed as Oil, Gas or Dry Hole) Oil
Date well completed 7-11-1944
Application for plugging filed 3-19-1957
Application for plugging approved 3-20-1957
Plugging commenced 4-17-1957
Plugging completed 4-22-1957
Reason for abandonment of well or producing formation Well was producing below its economic limit.
If a producing well is abandoned, date of last production 2-15 19 57
Was permission obtained from the Conservation Division or its agents before plugging was commenced? Yes

Name of Conservation Agent who supervised plugging of this well P. M. Brundege
Producing formation Arbuckle Depth to top 3346' Bottom 3358' Total Depth of Well 3358 Feet
Show depth and thickness of all water, oil and gas formations.

OIL, GAS OR WATER RECORDS

CASING RECORD

FORMATION	CONTENT	FROM	TO	SIZE	PUT IN	PULLED OUT
				8-5/8"	410'	- 0 -
				5-1/2"	3346'	2662'

Describe in detail the manner in which the well was plugged, indicating where the mud fluid was placed and the method or methods used in introducing it into the hole. If cement or other plugs were used, state the character of same and depth placed, from _____ feet to _____ feet for each plug set.

Well was plugged back to test Lansing-Kansas City. Plug back depth 3344 1/2'. No production obtained. Filled with sand to 2910', dumped 5 sacks cement. Filled with mud to 330'. Placed rock bridge and dumped 20 sacks cement. Filled with mud to 35'. Set rock bridge and capped with 10 sacks cement filling hole to base of cellar.

RECEIVED
STATE CORPORATION COMMISSION
APR 27 1957
CONSERVATION DIVISION
Wichita, Kansas

(If additional description is necessary, use BACK of this sheet)
Name of Plugging Contractor Morgan Well Plugging Service
Address 102 W. 18th St., Hutchinson, Kansas

STATE OF Kansas, COUNTY OF Sedgwick, ss.
Thomas A. Trax (employee of owner) or (owner or operator) of the above-described well, being first duly sworn on oath, says: That I have knowledge of the facts, statements, and matters herein contained and the log of the above-described well as filed and that the same are true and correct. So help me God.

(Signature) Thomas A. Trax
Box 2233, Wichita, Kansas
(Address)

SUBSCRIBED AND SWORN TO before me this 23rd day of April, 19 57

My commission expires 2-4-59

Ray W. Rouser
Ray W. Rouser Notary Public.

JRM:BJT

PLUGGING
 FILE SEC. 23 T. 16 R. 12W
 BOOK PAGE 149 LINE 21

15-009-03344-00-00

GULF OIL CORP.

MINNIE NO. 4

N/2 SW NE of Section 23-16S-12W
BARTON COUNTY, KANSAS

FROM	TO	FORMATION
0	415'	Shale and shells
8-5/8" O.D. casing cemented with 200 sacks Dewey bulk cement & 4 sacks calcium chloride		
415'	680'	Shale, shells and red bed
680'	1215'	Shale and shells
1215'	1260'	Shale
1260'	1375'	Salt and shale
1375'	1475'	Shale and shells
1475'	1630'	Lime
1630'	1855'	Lime and shale
1855'	2170'	Lime
2170'	2340'	Shale
2340'	2425'	Shale and shells
2425'	2500'	Lime and shale
2500'	2565'	Shale
2565'	3348'	Lime

108 joints of 5-1/2" O.D. casing cemented with 150 sacks bulk cement

T.D. 3348'

Drilled 10' deeper into Arbuckle with cable tools.

TD-3358'

RECEIVED
STATE CORPORATION COMMISSION

MAR 29 1937

CONSERVATION DIVISION
Topeka, Kansas

PLUGGING			
FILE	SEC. 23	T. 16	R. 12W
BOOK	PAGE 149	LINE	21