


15-009-03349-00-00

STATE OF KANSAS
STATE CORPORATION COMMISSION

Form CP-4

Give All Information Completely
Make Required Affidavit
Mail or Deliver Report to:
Conservation Division
State Corporation Commission
211 No. Broadway
Wichita, Kansas

WELL PLUGGING RECORD

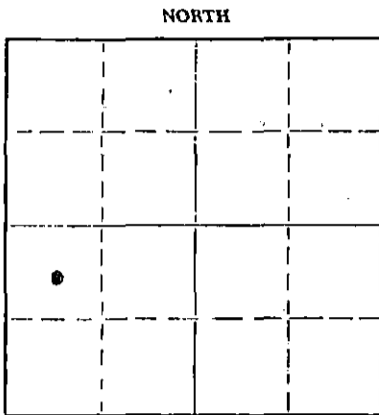

Locate well correctly on above
Section Plat

Location as "NE/CNWKSWK" or footage from lines Barton County, Sec. 23 Twp. 16 Rge. 12 (E) W (W)
Lease Owner M. J. Bove
Lease Name Rieman Well No. 4
Office Address Russell, Kansas
Character of Well (completed as Oil, Gas or Dry Hole) Oil
Date well completed 3-20-49 1949
Application for plugging filed 8-16-64 1964
Application for plugging approved 8-20-64 1964
Plugging commenced Aug. 20 1964
Plugging completed Aug. 22 1964
Reason for abandonment of well or producing formation Uneconomical Prod.

If a producing well is abandoned, date of last production 6-4 1964
Was permission obtained from the Conservation Division or its agents before plugging was commenced? Yes

Name of Conservation Agent who supervised plugging of this well Truan
Producing formation L-KC Depth to top 3114 Bottom 3118 Total Depth of Well 3366 Feet
Show depth and thickness of all water, oil and gas formations.

OIL, GAS OR WATER RECORDS

CASING RECORD

FORMATION	CONTENT	FROM	TO	SIZE	PUT IN	PULLED OUT
L-KC	O & W	3114	3118	8 1/8	158'	None
Regan-Sand	O & W	3361	3367	5 1/2	3364	2658

Describe in detail the manner in which the well was plugged, indicating where the mud fluid was placed and the method or methods used in introducing it into the hole. If cement or other plugs were used, state the character of same and depth placed, from 3366 feet to Surface feet for each plug set.

Sanded up to 3100' dump 5 sacks of cement on bottom. Pulled pipe up to 450' circ. mud. Pump 25 sacks of cement to 300', Pulled pipe up to 150' pump 20 sacks of cement to 150' pulled pipe out put 10 sacks on top. Well completed.

RECEIVED
STATE CORPORATION COMMISSION

SEP 14 1964 9-14-64

CONSERVATION DIVISION
Wichita, Kansas

(If additional description is necessary, use BACK of this sheet)

Name of Plugging Contractor Barnes & Sons Pipe Pulling Co.
Address P.O. Box 313 Russell, Kansas

STATE OF Kansas, COUNTY OF Russell, ss.
E. T. Drube (employee of owner) or (owner or operator) of the above-described

well, being first duly sworn on oath, says: That I have knowledge of the facts, statements, and matters herein contained and the log of the above-described well as filed and that the same are true and correct. So help me God.

(Signature) E. T. Drube E. T. Drube

Russell, Kansas

(Address)

SUBSCRIBED AND SWORN to before me this 10th day of September, 1964

Ruth E. Miller

Notary Public.

My commission expires January 5, 1965