


WELL PLUGGING RECORD

Give All Information Completely
Make Required Affidavit
Mail or Deliver Report to:
Conservation Division
State Corporation Commission
800 Bitting Building
Wichita, Kansas

NORTH

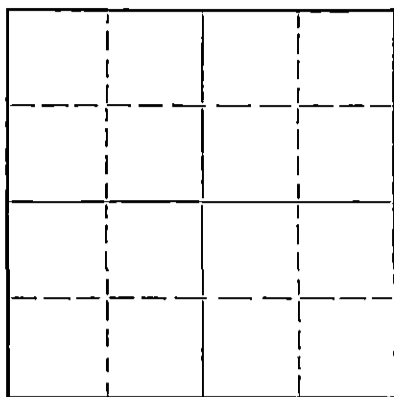

Locate well correctly on above
Section Plat

Barton County. Sec. 23 Twp. 16 Rge. 12(E)W (W)
Location as "NE/CNW $\frac{1}{4}$ SW $\frac{1}{4}$ " or footage from lines NE 4 $\frac{1}{2}$ CNE NE NW
Lease Owner Great Bend Pipe & Supply
Lease Name Warman Well No. 10
Office Address Great Bend Kas
Character of Well (completed as Oil, Gas or Dry Hole) Oil
Date well completed 4-10-54 1954
Application for plugging filed Aug 8 1954 19
Application for plugging approved Aug 4 1954 19
Plugging commenced 8-5-54 19
Plugging completed 8-6-54 19
Reason for abandonment of well or producing formation Lack of Oil

If a producing well is abandoned, date of last production _____ 19____
Was permission obtained from the Conservation Division or its agents before plugging was commenced? yes

Name of Conservation Agent who supervised plugging of this well Warren Horner
Producing formation 3418' Depth to top 3418' Bottom _____ Total Depth of Well 3464' Feet
Show depth and thickness of all water, oil and gas formations.

OIL, GAS OR WATER RECORDS

CASING RECORD

Formation	Content	From	To	Size	Put In	Pulled Out
8'	8 5/8" / 4 1/2"	Top	7.08'	4 1/2"	Cemented	1800'

Describe in detail the manner in which the well was plugged, indicating where the mud fluid was placed and the method or methods used in introducing it into the hole. If cement or other plugs were used, state the character of same and depth placed, from _____ feet to _____ feet for each plug set.

Placed unit on lease and pulled pipe at 1800'.
Plugged well under Mr. Horner's supervision.

(If additional description is necessary, use BACK of this sheet)

Correspondence regarding this well should be addressed to Forbes Casing Casing Co
Address Great Bend Kas

STATE OF Kansas COUNTY OF Barton, ss.
Warner Melby (employee of owner) or (owner or operator) of the above-described well,
being first duly sworn on oath, says: That I have knowledge of the facts, statements, and matters herein contained and the log of the above-described well as filed and that the same are true and correct. So help me God.

(Signature) Warner Melby
Great Bend Kas (Address)

SUBSCRIBED AND SWORN to before me this 12th day of August, 1954

My commission expires 3/30/57

23-5091-s 8-50-10M

PLUGGING
FILE SEC 23 T 16 R 12W
BOOK PAGE 53 LINE 29

RECEIVED
STATE CORPORATION COMMISSION
CONSERVATION DIVISION
Wichita, Kansas
AUG 16 1954 8-16-54

WELL LOG BUREAU - KANSAS GEOLOGICAL SOCIETY
412 Union National Bk. Bldg., Wichita, Kansas


15-009-03352-00-00

Company - SHELL OIL CO., INC.
Farm - H. Riemann No. 1.

SEC. 23 T. 16 R. 12 W
C1N1 NE NW
330' FNL 659' FEL NW $\frac{1}{4}$

Total Depth. 3464' PB 3418'
Comm. 3-3-44 Comp. 4-10-44
Shot or Treated.
Contractor.
Issued. 5-13-44

County. Barton
KANSAS

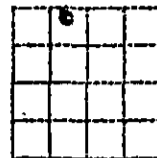

CASING:
8 5/8" 708' Com.
4 1/2" 3418'

Elevation. _____

Production. Pot. 1676 B., No Wtr

Figures Indicate Bottom of Formations.

surface clay	35
lime	150
shale, sand, lime	285
red bed	330
red bed & shale	504
shale	708
red rock	810
shale & shells	1050
shale & salt	1464
shale & shells	1504
shale & lime	1900
lime	1947
shale & lime	2295
shale & shells	2477
shale & lime	2674
2674 equals 2674 SIM	
shale & lime	2712
lime	3355
sand & shale	3359
shale	3371
sand	3380
shale	3389
lime	3399
shale	3456
granite weathered	3464
Total Depth.	

Plugged back 3418

Tops: Topeka 2685
Lansing-K.C. 3092
Socy Congl. 3352 Corr.
Socy Sand 3355
Pre-Cambrian,
Weathered
Granite 3459 Corr.

PLUGGING
FEL SEC 23 T 16 R 12W
BOOK PAGE 53 LINE 29

RECEIVED
STATE GEOLOGICAL SURVEY
WICHITA, KANSAS