

15-009-07019-00-00


STATE OF KANSAS
STATE CORPORATION COMMISSION

Form CP-4

Give All Information Completely
Make Required Affidavit
Mail or Deliver Report to:
Conservation Division
State Corporation Commission
212 No. Market
Wichita, Kansas

WELL PLUGGING RECORD

NORTH

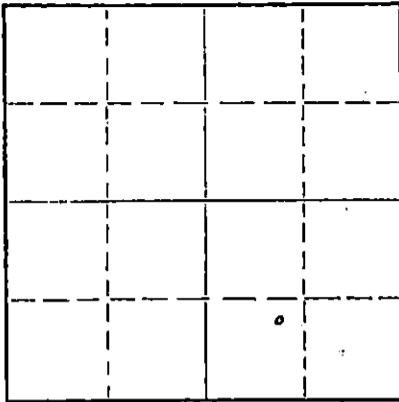

Locate well correctly on above
Section Plat

Barton County. Sec. 23 Twp. 16 Rge. 12 (E) 12 (W)
Location as "NE/CNW&SW&" or footage from lines NE SW SE
Lease Owner Harms Petroleum Company
Lease Name Hofmeister Well No. 1
Office Address Box 488, Great Bend, Kansas
Character of Well (completed as Oil, Gas or Dry Hole) oil
Date well completed _____ 19____
Application for plugging filed January 9 19 67
Application for plugging approved _____ 19____
Plugging commenced January 12 19 67
Plugging completed January 14 19 67
Reason for abandonment of well or producing formation depleted

If a producing well is abandoned, date of last production _____ 19____
Was permission obtained from the Conservation Division or its agents before plugging was commenced? yes

Name of Conservation Agent who supervised plugging of this well Donald Truan
Producing formation _____ Depth to top _____ Bottom _____ Total Depth of Well 3343 Feet
Show depth and thickness of all water, oil and gas formations.

OIL, GAS OR WATER RECORDS

CASING RECORD

FORMATION	CONTENT	FROM	TO	SIZE	PUT IN	PULLED OUT
		0	184'	8 5/8"	184'	none
		0	3339'	5 1/2"	3339'	588.18

Describe in detail the manner in which the well was plugged, indicating where the mud fluid was placed and the method or methods used in introducing it into the hole. If cement or other plugs were used, state the character of same and depth placed, from _____ feet to _____ feet for each plug set.

Pushed plug to 2900', set 10' rock bridge and dumped 5 sacks of cement at 2890'.

Filled hole with mud to 290', set 20' rock bridge and dumped 5 yards of redi-mix concrete. Filled to top of ground level in cellar.

RECEIVED
STATE CORPORATION COMMISSION

JAN 25 1967

CONSERVATION DIVISION
Wichita, Kansas

(If additional description is necessary, use BACK of this sheet)

Name of Plugging Contractor Pipe Pullers, Inc.
Address Box 486, Ellinwood, Kansas

STATE OF Kansas, COUNTY OF Barton, ss.
Dean Wells (employee of owner) or (owner-operator) of the above-described well, being first duly sworn on oath, says: That I have knowledge of the facts, statements, and matters herein contained and the log of the above-described well as filed and that the same are true and correct. So help me God.

(Signature)

Ellinwood, Kansas

(Address)

SUBSCRIBED AND SWORN to before me this 20th day of January, 19 67

My commission expires July 7, 1968

Notary Public.