


STATE OF KANSAS
STATE CORPORATION COMMISSION

WELL PLUGGING RECORD

Give All Information Completely
Make Required Affidavit
Mail or Deliver Report to:
Conservation Division
State Corporation Commission
300 Bitting Building
Wichita, Kansas

STAFFORD County, Sec. 17 Twp. 21 Rge. (E) 12 (W)
Location as "NE/CNW/SW" or footage from lines SW SW NE
Lease Owner E. H. Adair
Lease Name Westafer Well No. 1
Office Address 407 W-K-H Building, Wichita 2, Kansas
Character of Well (completed as Oil, Gas or Dry Hole) Dry Hole
Date well completed January 31 1951
Application for plugging filed January 31 1951
Application for plugging approved January 31 1951
Plugging commenced January 31, 1951
Plugging completed January 31 1951
Reason for abandonment of well or producing formation Barren

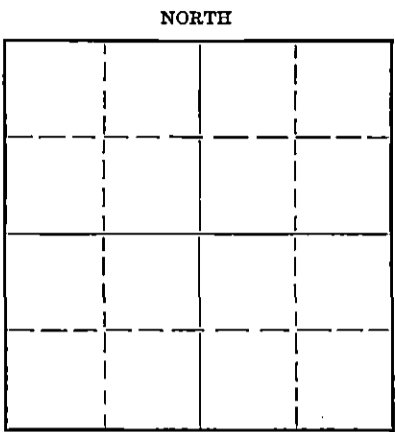

Locate well correctly on above
Section Flat

If a producing well is abandoned, date of last production 19
Was permission obtained from the Conservation Division or its agents before plugging was commenced? Yes

Name of Conservation Agent who supervised plugging of this well C. D. Stough
Producing formation Depth to top Bottom Total Depth of Well 3590' Feet
Show depth and thickness of all water, oil and gas formations.

OIL, GAS OR WATER RECORDS

CASING RECORD

Formation	Content	From	To	Size	Put In	Pulled Out
Copy of well log attached						

Describe in detail the manner in which the well was plugged, indicating where the mud fluid was placed and the method or methods used in introducing it into the hole. If cement or other plugs were used, state the character of same and depth placed, from feet to feet for each plug set.

Plugged hole, placed wooden plug at 300'
put 15 sacks cement on plug, filled hole
with mud up to 30' of top, placed plug
and cemented up to surface with 10 sacks

RECEIVED
STATE CORPORATION COMMISSION
FEB 12 1951
CONSERVATION DIVISION
WICHITA, KANSAS

(If additional description is necessary, use BACK of this sheet)

Correspondence regarding this well should be addressed to E. H. Adair Oil Company
Address Wichita, Kansas

STATE OF Kansas, COUNTY OF Sedgwick, ss.
E. H. Adair (employee of owner) or (owner or operator) of the above-described well,
being first duly sworn on oath, says: That I have knowledge of the facts, statements, and matters herein contained and the log of the above-described well as filed and that the same are true and correct. So help me God.

(Signature) [Signature]
Wichita, Kansas
(Address)

SUBSCRIBED AND SWORN to before me this 8th day of February, 1951

[Signature]
Notary Public.

My commission expires September 15, 1953

PLUGGING
FILE SEC 17 T 21 R 12
PAGE 59 LINE 32

15.185.11805.0000

E. H. ADAIR OIL COMPANY

Sec. 17 T 21 R 12 W

Westafer Well No. 1.

SW SW NE Barton County,

Commn. 1/21/51 Comp. 1/31/51
Total Dept 3590'
327' 8 5/8" surface casing
200-sx cement.

Elevation 1862 DF
1860 Gr

Sand	0-245	
Shale & Shells	245-327	
Red Bed	327-500	
Shale & Shells	500-1220	
Shale	1220-1465	
Lime	1465-1905	
Shale & Lime	1905-2030	
Lime	2030-2085	
Shale & Lime	2085-2130	
Lime	2130-2375	
Lime & Shale	2375-2485	
Shale	2485-2830	
Lime	2830-2860	
Lime & Shale	2860-2885	
Lime	2885-3590	Rotary

Certified Correct

R. L. Baker

RECEIVED
STATE CORPORATION COMMISSION
FEB 12 1951

PLUGGING
FILE SEC-17 T 21 R 12 W
BOOK PAGE 59 LINE 32