


WELL PLUGGING RECORD

Give All Information Completely  
Make Required Affidavit  
Mail or Deliver Report to:  
Conservation Division  
State Corporation Commission  
800 Bittling Building  
Wichita, Kansas

NORTH

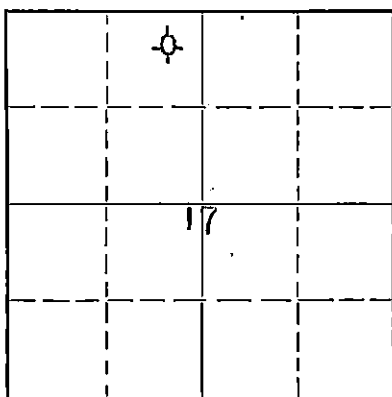

Locate well correctly on above  
Section Flat

STAFFORD County. Sec. 17 Twp. 21 Rge. (E) 12 (W)  
Location as "NE/CNW $\frac{1}{4}$ SW $\frac{1}{4}$ " or footage from lines NE $\frac{1}{2}$  NE $\frac{1}{4}$  NW $\frac{1}{4}$   
Lease Owner DERBY DRILLING COMPANY  
Lease Name JOHNSON Well No. 1  
Office Address 352 NORTH BROADWAY, WICHITA 2, KANSAS  
Character of Well (completed as Oil, Gas or Dry Hole) OIL  
Date well completed JULY 5, 1950  
Application for plugging filed NOVEMBER 29, 1951  
Application for plugging approved NOVEMBER 30, 1951  
Plugging commenced JANUARY 21, 1952  
Plugging completed JANUARY 27, 1952  
Reason for abandonment of well or producing formation NON-COMMERCIAL

If a producing well is abandoned, date of last production DECEMBER 31, 1951  
Was permission obtained from the Conservation Division or its agents before plugging was commenced? YES

Name of Conservation Agent who supervised plugging of this well C. D. STOUGH, BOX 207, GREAT BEND, KANSAS  
Producing formation ARBUCKLE Depth to top 3487 Bottom 3490 Total Depth of Well 3490 Feet  
Show depth and thickness of all water, oil and gas formations.

OIL, GAS OR WATER RECORDS

CASING RECORD

Formation	Content	From	To	Size	Put In	Pulled Out
				8-5/8	252	NONE
				5-1/2	3490	2663

Describe in detail the manner in which the well was plugged, indicating where the mud fluid was placed and the method or methods used in introducing it into the hole. If cement or other plugs were used, state the character of same and depth placed, from \_\_\_\_\_ feet to \_\_\_\_\_ feet for each plug set.

SANDED HOLE FROM 3545' TO 3350' AND RAN  
5 SACKS OF CEMENT. BAILED HOLE. MUDDED  
HOLE TO 250', SET 10' ROCK BRIDGE AND RAN  
15 SACKS OF CEMENT. MUDDED HOLE TO 35'  
AND RAN 10 SACKS OF CEMENT. PLUGGING  
COMPLETED.

Stamp

FEB 27 1952

2-27-52

CONSERVATION DIVISION

(If additional description is necessary, use BACK of this sheet), KANSAS

Name of Plugging Contractor WEST SUPPLY COMPANY  
Address CHASE, KANSAS

STATE OF KANSAS, COUNTY OF SEDGWICK, SS.  
B. W. BURKS (employee of owner) or (owner or operator) of the above-described well,  
being first duly sworn on oath, says: That I have knowledge of the facts, statements, and matters herein contained and the log of the above-  
described well as filed and that the same are true and correct. So help me God


(Signature) *B. W. Burks*

352 NORTH BROADWAY, WICHITA 2, KANSAS (Address)

SUBSCRIBED AND SWORN to before me this 26TH day of FEBRUARY, 1952

*Barbara Henry*  
Notary Public.

My commission expires DECEMBER 3, 1955

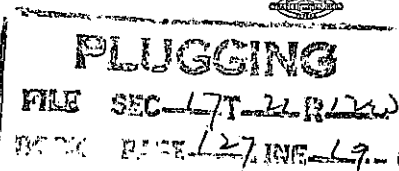

Derby Drilling Company, et al  
Production Department  
Wichita, Kansas

Johnston #1  
CNE NE NW, 17-21-12W  
Stafford County, Kansas

Elevation: 1855 D.F.  
Spudded: June 26, 1950  
Rotary Completed: July 5, 1950  
Cable Tools Completed:  
Acid Treatment:  
Initial Production:  
Contractor: Derby Drilling Company

CASING RECORD

252' 8-5/8" 24# Surface Casing, cemented with 175 sacks cement.  
3490' 5-1/2" 15# Seamless Casing, cemented with 125 sacks cement.

DRILLERS LOG

Sand	0 to	163	Lime	1860 to	2085
Shale & sand		252	Lime & shale		2820
Shale & Redrock		480	Lime		3080
Red shale		665	Lime & shale		3280
Anhydrite		692	Lime		3459
Shale & shells		960	Lime & shale		3492 T.D.
Shale & salt		1450		3492 T.D. =	3490 D.F.
Shale & lime		1845			
Sand		1860			

STATE OF KANSAS )  
                          ) SS  
COUNTY OF SEDGWICK)

I hereby certify that to the best of my knowledge and belief, the foregoing log is true and correct.

DERBY DRILLING COMPANY

By: *[Signature]*

Subscribed and sworn to before me, a Notary Public, in and for the State and County aforesaid this 29th day of NOVEMBER, 1950 1951.

*[Signature]*  
Notary Public

My Commission Expires  
7-19-54

RECEIVED  
STATE OF KANSAS COMMISSION

PLUGGING NOV 30 1951

FILE SEC-17T-21R-12W

BOOK PAGE 127 LINE 19

NOTARY DIVISION  
Wichita, Kansas