


WELL PLUGGING RECORD

Give All Information Completely
Make Required Affidavit
Mail or Deliver Report to:
Conservation Division
State Corporation Commission
800 Bitting Building
Wichita, Kansas

NORTH

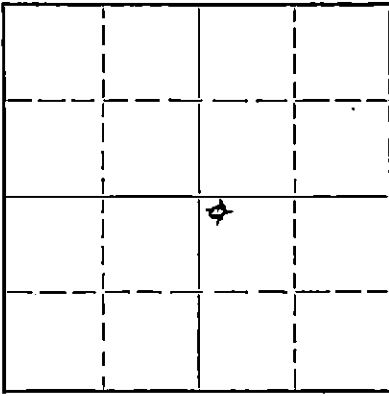

Locate well correctly on above
Section Plat

Stafford County, Sec. 14 Twp. 21s Rge. 12 (E) (W)
Location as "NE/CNW $\frac{1}{4}$ /SW $\frac{1}{4}$ " or footage from lines NW NW SE
Lease Owner Virginia Drilling Co., Inc. & Franco Central Oil Co.
Lease Name Roberts Well No. 3
Office Address 701 Brown Bldg., Wichita 2, Kansas
Character of Well (completed as Oil, Gas or Dry Hole) dry hole
Date well completed January 26, 1951
Application for plugging filed March 4 1951
Application for plugging approved March 4 1951
Plugging commenced March 4 1951
Plugging completed March 4 1951
Reason for abandonment of well or producing formation dry

If a producing well is abandoned, date of last production 19
Was permission obtained from the Conservation Division or its agents before plugging was commenced? yes

Name of Conservation Agent who supervised plugging of this well C. D. Stough, Box 207, Great Bend, Kansas
Producing formation Depth to top Bottom Total Depth of Well Feet
Show depth and thickness of all water, oil and gas formations.

OIL, GAS OR WATER RECORDS

CASING RECORD

Formation	Content	From	To	Size	Put In	Pulled Out
				8-5/8"	292	none
				5 1/2	3586	2926

Describe in detail the manner in which the well was plugged, indicating where the mud fluid was placed and the method or methods used in introducing it into the hole. If cement or other plugs were used, state the character of same and depth placed, from feet to feet for each plug set.

3260 ft. - 3230 ft. - Filled with sand
3230 " to 3200 " - 5 sacks cement
3200 " to 280 " - Mudded
280 " to 265 " - Rock Bridge
265 " to 25 " - Mud
25 " to cellar - 10 sacks cement

RECEIVED
STATE CORPORATION COMMISSION

3-16-51 MAR 16 1951

CONSERVATION DIVISION
Wichita, Kansas

(If additional description is necessary, use BACK of this sheet)

Correspondence regarding this well should be addressed to Virginia Drilling Co., Inc.
Address 701 Brown Bldg., Wichita 2, Kansas

STATE OF Kansas, COUNTY OF Sedgwick, ss.

S. A. Murphy (employee of owner) or (owner or operator) of the above-described well,
being first duly sworn on oath, says: That I have knowledge of the facts, statements, and matters herein contained and the log of the above-described well as filed and that the same are true and correct. So help me God.

(Signature) S. A. Murphy

701 Brown Bldg., Wichita 2, Kansas
(Address)

SUBSCRIBED AND SWORN to before me this 12th day of March, 1951

Inez M. Newman
Notary Public.

My commission expires March 15, 1954

PLUGGING
FILE SEC 14 T 21 R 12
BOOK PAGE 6612


Well: Roberts No. 3
 Location: NW NW SE/4 Section 14-21s-12w, Stafford County, Kansas
 Company: Virginia Drilling Co., Inc. & Franco Central Oil Co.
 Contractor: Virginia Drilling Co., Inc.
 Commenced: August 7, 1950
 Completed: January 26, 1951
 Total Depth: 3686
 Elevation: 1841 D.F.

FORMATION	DEPTH	
Sand-shell-shale	0-225	Set 8-5/8" csg. @ 292'
R. rock-sand	225-286	Set 5 1/2" csg. @ 3586'
Shells-red bed	286-635	
Anhydrite	635-647	
R B Shale-shells	647-915	
Shale-shell	915-1275	
Salt-shale	1275-1485	
Shale-lime	1485-1820	TOPS:
Lime-sand-shale	1820-1900	Heebner 3086
Lime-shale	1900-2660	Lansing 3228
Shale-shells	2660-2770	Conglomerate 3476
Lime-shale	2770-2930	Viola 3516
Lime	2930-2995	Simpson 3544
Lime-shale	2995-3040	Arbuckle 3582
Chert-lime	3040-3065	
Cherty Lime-shale	3065-3110	
Shale-lime shells	3110-3195	
Shale	3195-3221	
Lime-shale	3221-3365	
Shale	3365-3375	
Lime-shale	3375-3479	
Lime-shert	3479-3485	
Lime-shale	3485-3500	
Chert-conglomerate	3500-3510	
Cherty Lime	3510-3545	
Shale	3545-3570	
Lime-shale	3570-3588	
Lime Cherty	3588-3629	
Sandy Lime	3629-3654	
Lime	3654-3680	
Green Shale	3680-3686	

Now comes S. A. Murphy, who states that he is familiar with the drilling of oil and gas wells and knows of his own knowledge that the Roberts #3 located in the NW NW SE/4 Section 14-21s-12w, Stafford County, Kansas, was drilled to a total depth of 3686 feet. Same was plugged and abandoned.

Subscribed and sworn to before me this 12th day of March, 1951

My commission expires March 15, 1954.

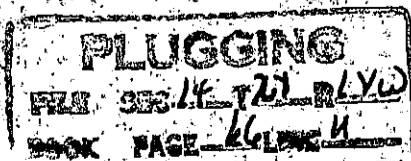

RECEIVED
 STATE CORPORATION COMMISSION
 MAR 16 1951
 CONSERVATION DIVISION
 Wichita, Kansas