


WELL PLUGGING RECORD

Give All Information Completely
Make Required Affidavit
Mail or Deliver Report to:
Conservation Division
State Corporation Commission
800 Bitting Building
Wichita, Kansas

NORTH

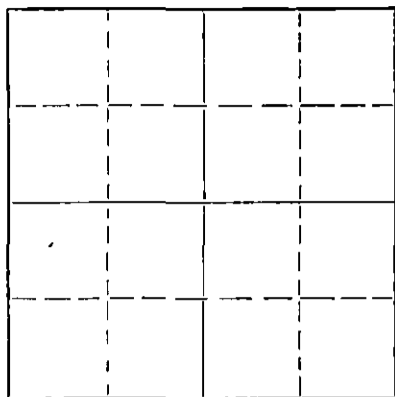

Locate well correctly on above
Section Plat

Stafford County. Sec. 9 Twp. 21 Rge. 12 (E) W (W)
Location as "NE/CNW/SW" or footage from lines NW NW NE
Lease Owner Duke and Wood Drilling Company
Lease Name Burhenn Well No. 1
Office Address Box 123, Great Bend, Kansas
Character of Well (completed as Oil, Gas or Dry Hole) Oil Well
Date well completed March 7 19 51
Application for plugging filed April 20 19 53
Application for plugging approved April 21 19 53
Plugging commenced April 30 19 53
Plugging completed April 30 19 53
Reason for abandonment of well or producing formation went dry

If a producing well is abandoned, date of last production December 19 52
Was permission obtained from the Conservation Division or its agents before plugging was commenced? Yes

Name of Conservation Agent who supervised plugging of this well Mr. M. A. Rives
Producing formation Arbuckle Depth to top 3459 Bottom 3492 Total Depth of Well 3492 Feet
Show depth and thickness of all water, oil and gas formations.

OIL, GAS OR WATER RECORDS

CASING RECORD

FORMATION	CONTENT	FROM	TO	SIZE	PUT IN	PULLED OUT
				8 5/8	XX 239	None
				5 1/2	3492	2300.5

Describe in detail the manner in which the well was plugged, indicating where the mud fluid was placed and the method or methods used in introducing it into the hole. If cement or other plugs were used, state the character of same and depth placed, from _____ feet to _____ feet for each plug set.

Plugged back 5 1/2" OD casing with crushed rock to 3325', Mixed and dumped 5 sacks of cement on same, filled hole with heavy mud to 225 feet, set 5 ft. rock bridge, mixed and dumped 20 sacks of cement on same. Filled hole with heavy mud to 36 feet, set 5 ft. rock bridge mixed and dumped 10 sacks of cement on same.


(If additional description is necessary, use BACK of this sheet)
Name of Plugging Contractor Ace Pipe Pulling Company
Address P.O. Box 304, Great Bend, Kansas

STATE OF Kansas, COUNTY OF Barton, ss.
Lynn O. Duke (owner or operator) of the above-described well, being first duly sworn on oath, says: That I have knowledge of the facts, statements, and matters herein contained and the log of the above-described well as filed and that the same are true and correct. So help me God.

(Signature) Lynn O. Duke
Great Bend, Kansas (Address)

SUBSCRIBED AND SWORN TO before me this 20th day of May, 19 53
Dean E. Looney Notary Public.

My commission expires April 29, 1957

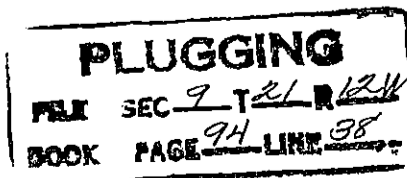

15.185.12835.0000

WELL LOG
Burhenn #1
NW NW NE Sec. 9-21-12W
Stafford County, Kansas

Started: February 24, 1951
Completed: March 7, 1951

Elevation 1847' R. B.
Anhydrite 622' (-1225')
Heebner 3056' (-1209')
Lansing 3202' (-1357')
Conglomerate 3422' (-1575')
Simpson Sand 3458' (-1611')
Arbuckle 3459' (-1612')

0-230	Sand and clay
230-239	Red Bed
239-510	Red bed and shale
510-622	Sand, red bed and shale
622-659	Anhydrite
659-1230	Shale, shells and salt
1230-1585	Shale, shells and lime streaks
1585-1850	Shale and lime
1850-2090	Shale and lime
2090-2505	Shale and lime
2505-2829	Shale and lime
2829-2930	Lime
2930-3045	Lime
3045-3190	Lime
3190-3310	Lime
3310-3420	Lime
3420-3444	Conglomerate
3444-3463	Conglomerate, S. sand and lime
3463-3492	Lime
3492	TOTAL ROTARY DEPTH

A F F I D A V I T

STATE OF Kansas, COUNTY OF Barton SS

I, Lynn O. Duke, of the DUKE & WOOD DRUG Company, INC. being first duly sworn on oath, state; That I have knowledge of the facts, statements and matters herein contained and that the same are true and correct.

PLUGGING
PLK SEC 9 T 21 R 12W
BOOK PAGE 94 LINE 38

Lynn O. Duke
Vice-President

Subscribed and sworn to before me this 21 day of March 1951.

COMMISSION

Dean T. Coley
Notary Public

My commission expires: April 29, 1953.