


STATE OF KANSAS
STATE CORPORATION COMMISSION

WELL PLUGGING RECORD

Give All Information Completely
Make Required Affidavit
Mail or Deliver Report to:
Conservation Division
State Corporation Commission
211 No. Broadway
Wichita, Kansas

Stafford County. Sec. 9 Twp. 21S Rge. 12 (E) W (W)
Location as "NE/CNWxSWx" or footage from lines SW SW SW
Lease Owner L. K. Parrish
Lease Name Dewerff Well No. 1
Office Address 714 Fourth National Bldg., Wichita, Kansas
Character of Well (completed as Oil, Gas or Dry Hole) Dry Hole
Date well completed December 3, 1964
Application for plugging filed December 3, 1964
Application for plugging approved December 3, 1964
Plugging commenced December 3, 1964
Plugging completed December 3, 1964
Reason for abandonment of well or producing formation Too low structurally

NORTH

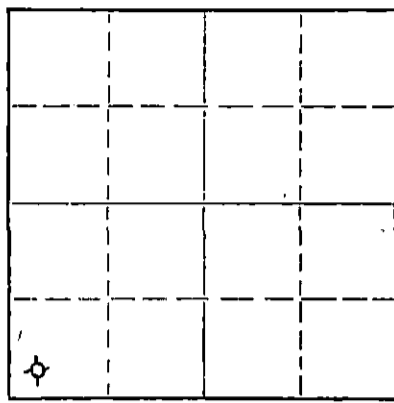

Locate well correctly on above Section Plat

If a producing well is abandoned, date of last production _____ 19____
Was permission obtained from the Conservation Division or its agents before plugging was commenced? Yes

Name of Conservation Agent who supervised plugging of this well Archie V. Elving, Pratt, Kansas
Producing formation _____ Depth to top _____ Bottom _____ Total Depth of Well 3543 Feet
Show depth and thickness of all water, oil and gas formations.

OIL, GAS OR WATER RECORDS

CASING RECORD

FORMATION	CONTENT	FROM	TO	SIZE	PUT IN	PULLED OUT
				8-5/8"	279'	None

Describe in detail the manner in which the well was plugged, indicating where the mud fluid was placed and the method or methods used in introducing it into the hole. If cement or other plugs were used, state the character of same and depth placed, from _____ feet to _____ feet for each plug set.

Filled hole with heavy mud to 260'. Set plug. Put in 25 sacks cement. Filled hole with heavy mud to 40'. Set Plug. Filled to top with 10 sacks cement.

RECEIVED
STATE CORPORATION COMMISSION

DEC 9 1964

CONSERVATION DIVISION
Wichita, Kansas

12-9-64

(If additional description is necessary, use BACK of this sheet)
Name of Plugging Contractor C-G Drilling Co.
Address 107 Rule Building, Wichita, Kansas


STATE OF KANSAS, COUNTY OF SEDGWICK, ss.
Jay H. Galloway (employee of owner) or (owner or operator) of the above-described

well, being first duly sworn on oath, says: That I have knowledge of the facts, statements, and matters herein contained and the log of the above-described well as filed and that the same are true and correct. So help me God.

(Signature) Jay H. Galloway
107 Rule Building
(Address)

Subscribed and sworn to before me this 7th day of December, 1964

May 20, 1967
Vicky Jacobs
Notary Public.

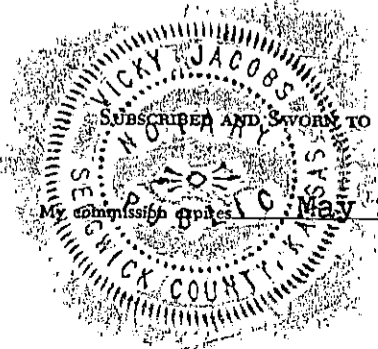

W E L L L O G

OPERATOR: L. K. PARRISH

WELL NAME: DEWERFF #1 LOCATION: SW SW SW Sec. 9-21S-12W

COUNTY: Stafford STATE: Kansas

WELL COMMENCED: 11/25/64 WELL COMPLETED: 12/3/64

ELEVATION: 1852' K.B. TOTAL DEPTH: 3543'

PRODUCTION: Dry & Abandoned RIG NO: 2

CASING - 8-5/8": Set 279' (8 jts) 8-5/8" OD Surface Casing w/250 sks Quickset
 5-1/2": _____

All Measurements taken from the top of rotary bushing.

FROM	TO	FORMATION	DEVIATION FROM VERTICAL	REMARKS:
0	230	Sand		
230	279	Shale		
269	645	Red Bed	500' - 1/2°	
645	670	Anhydrite		
670	1500	Shale & Shells	1000' - 1/2°	
1500	3000	Lime & Shale	1500' - 1/4°	
3000	3543	Lime	2000' - 1/4° 2500' - 1/4°	DST 3525-3535' DST 3530-3543'

RECEIVED
STATE CORPORATION COMMISSION

DEC 9 1964

CONSERVATION DIVISION
Wichita, Kansas

STATE OF KANSAS
COUNTY OF SEDGWICK) SS:

The undersigned hereby certifies that to the best of his knowledge and belief, the above facts are true and correct.

C-G DRILLING CO.

By G. F. Galloway
G. F. Galloway

SUBSCRIBED AND SWORN TO, BEFORE ME, This 7th day of December, 1964.

My comm. exp. May 20, 1967

Vicky Jacobs
Vicky Jacobs - Notary Public

