

STATE OF KANSAS
STATE CORPORATION COMMISSION


WELL PLUGGING RECORD

Give All Information Completely
Make Required Affidavit
Mail or Deliver Report to:
Conservation Division
State Corporation Commission
211 No. Broadway
Wichita, Kansas

Stafford County. Sec. 9 Twp 21s Rge. 12W (E) (W)

Location as "NE/CNW/SW" or footage from lines SW NW NE
Lease Owner Virginia Drilling Co Inc.
Lease Name Burhenn Well No. 1
Office Address 712 Brown Bldg- Wichita, Kans 67202
Character of Well (completed as Oil, Gas or Dry Hole) dry hole
Date well completed April 25, 1965 19
Application for plugging filed " 19
Application for plugging approved " 19
Plugging commenced " 19
Plugging completed " 19
Reason for abandonment of well or producing formation

NORTH

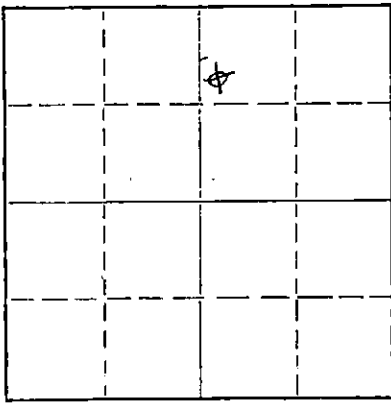

Locate well correctly on above
Section Plat

If a producing well is abandoned, date of last production 19
Was permission obtained from the Conservation Division or its agents before plugging was commenced? yes

Name of Conservation Agent who supervised plugging of this well Archie Elving - Pratt, Kans
Producing formation _____ Depth to top _____ Bottom _____ Total Depth of Well 3510 Feet
Show depth and thickness of all water, oil and gas formations.

OIL, GAS OR WATER RECORDS

CASING RECORD

FORMATION	CONTENT	FROM	TO	SIZE	PUT IN	PULLED OUT
		0	270	8 5/8"	273.	none

Describe in detail the manner in which the well was plugged, indicating where the mud fluid was placed and the method or methods used in introducing it into the hole. If cement or other plugs were used, state the character of same and depth placed, from _____ feet to _____ feet for each plug set.

Mudded to 240 ft. w/ heavy mud- set plug w/ 25 sx cement 1/4 sx hulls
Mudded to 40 ft. set plug w/ 10 sx cement 1/4 sx hulls
3 sx cement in rat hole

RECEIVED
STATE CORPORATION COMMISSION
APR 23 1965
CONSERVATION DIVISION
Wichita, Kansas

(If additional description is necessary, use BACK of this sheet)
Name of Plugging Contractor Virginia Drilling Co Inc
Address 712 Brown Bldg- Wichita, Kans 67202

STATE OF Kansas, COUNTY OF Sedgwick, ss.
S. A. Murphy (employee of owner) or (owner or operator) of the above-described well, being first duly sworn on oath, says: That I have knowledge of the facts, statements, and matters herein contained and the log of the above-described well as filed and that the same are true and correct. So help me God.

(Signature) *S. A. Murphy*
712 Brown Bldg- Wichita, Kans 67202
(Address)

SUBSCRIBED AND SWORN TO before me this 26 day of April, 19 65
Charles Hawley
Notary Public.

My commission expires 2-5-69



15.185.30043.0000

SW NW

FURHENN # 1 - NE/4 Section 9-21S-12W Stafford County, Kansas
Company - VIRGINIA DRILLING CO., INC.
Contractor - VIRGINIA DRILLING CO., INC.
Commenced - April 17, 1965
Completed - April 25, 1965
Elevation - 1841 DF
Total Depth - 3510

8 5/8" set @ 270' w/ 200 sx. cem.
Dry Hole

Formation	Depth
Surface soil - Sand	0 - 225
Red Bed	225 - 700
Shale & Shells	700 - 1465
Lime & Shale	1465 - 2941
Lime	2941 - 3058
Heebner - Shale	3058 - 3063
Lime & Shale	3063 - 3265
Lime	3265 - 3430
Shale	3430 - 3460
Lime & Shale	3460 - 3475
Lime	3475 - 3510 TD

A. A. Murphy

Subscribed and sworn to before me, a Notary Public, this 27th day
of April, 1965.

W. M. Hawley
Notary Public

My commission expires: 2 - 5 - 69

RECEIVED
STATE CORPORATION COMMISSION

APR 28 1965

CONSERVATION DIVISION
Wichita, Kansas