

STATE OF KANSAS  
STATE CORPORATION COMMISSION

Form CP-4


Give All Information Completely  
Make Required Affidavit  
Mail or Deliver Report to:  
Conservation Division  
State Corporation Commission  
212 No. Market  
Wichita, Kansas

WELL PLUGGING RECORD

Stafford County, Sec. 9 Twp. 21 Rge. 2122 (W)

Location as "NE/CNW/SW" or footage from lines SE NW SW  
Lease Owner Clinton Oil Company  
Lease Name Ruth DeWerff Well No. 3-D  
Office Address 217 No. Water - Wichita, Kansas 67202  
Character of Well (completed as Oil, Gas or Dry Hole) Dry hole  
Date well completed 11-26-1971  
Application for plugging filed 11-26-1971  
Application for plugging approved 12-1-1971  
Plugging commenced 11-26-1971  
Plugging completed 11-26-1971  
Reason for abandonment of well or producing formation Dry hole

NORTH

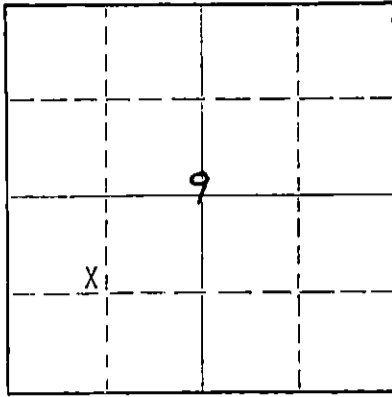

Locate well correctly on above Section Plat

If a producing well is abandoned, date of last production 19\_\_\_\_  
Was permission obtained from the Conservation Division or its agents before plugging was commenced? Yes - Verbal approval 11-26-71

Name of Conservation Agent who supervised plugging of this well Russell Biberstein - Attica, Kansas  
Producing formation Arbuckle Depth to top 3475 Bottom 3550 Total Depth of Well 3491 Feet  
Show depth and thickness of all water, oil and gas formations.

OIL, GAS OR WATER RECORDS

CASING RECORD

FORMATION	CONTENT	FROM	TO	SIZE	PUT IN	PULLED OUT
Arbuckle	Oil	3475	3550	8 5/8	444	None
Lansing/KC	"	3205	3425			
Topeka	"	2790	3060			

Describe in detail the manner in which the well was plugged, indicating where the mud fluid was placed and the method or methods used in introducing it into the hole. If cement or other plugs were used, state the character of same and depth placed, from \_\_\_\_\_ feet to \_\_\_\_\_ feet for each plug set.

1st plug set at 650' w/30 sx. 2nd plug set at 400' w/20 sx,  
3rd plug at 40 ft w/10 sx plus 25 sx for rat hole

RECEIVED  
STATE CORPORATION COMMISSION  
DEC 6 1971  
CONSERVATION DIVISION  
Wichita, Kansas

12-6-71

(If additional description is necessary, use BACK of this sheet)

Name of Plugging Contractor Gabbert & Jones Inc.  
Address 830 Sutton Place - Wichita, Kansas

STATE OF Kansas, COUNTY OF Sedgwick, ss. \_\_\_\_\_ (employee of owner) or (owner or operator) of the above-described well, being first duly sworn on oath, says: That I have knowledge of the facts, statements, and matters herein contained and the log of the above-described well as filed and that the same are true and correct. So help me God.

(Signature) Gary M. Carney  
217 North Water, Wichita, Kansas  
(Address)



Subscribed and sworn to before me this 3rd day of December, 1971  
Allen T. Denton  
Notary Public.

My commission expires January 24, 1972

GABBERT-JONES, INC.  
WICHITA, KANSAS  
DRILLERS' WELL CORPORATION  
RECEIVED  
DEC 6 1971  
CONSERVATION DIVISION  
Wichita, Kansas

RUTH DEWERFF #3D  
SE NW SW, Sec. 9-21S-12W  
Stafford County, Kansas

Commenced: November 16, 1971  
Completed: November 26, 1971

OPERATOR: CLINTON OIL CO.

Depth	Formation	Remarks
From To		
0 220	Sand and shale	Ran 11 jts of new 20# 8 5/8" csg.
220 662	Redbed and shale	Set @ 444' w/225 sks 50-50 Posmix
662 670	Anhydrite	2% Gel - 2% CC - 100 Sks Common
670 1525	Shale and shells	w/2% CC
1525 3020	Lime and shale	P.D. 7 PM. Cement Circ. 11/16/71
3020 3489	Lime	
3489 3491	Lime and chert	
3491 TD		Dry and abandoned

I, James S. Sutton II, certify this is a correct copy of the Drillers' Log for the well drilled in the SE NW SW, Section 9-21S-12W, Stafford County, Kansas, to the best of my knowledge and belief.

*James S. Sutton II*  
James S. Sutton II

STATE OF KANSAS )  
                          ) SS  
COUNTY OF SEDGWICK )

Before me, the undersigned, a Notary Public within and for said County and State, on this 30th day of November, 1971, personally appeared James S. Sutton II to me personally known to be the identical person who executed the within and foregoing instrument and acknowledged to me that he executed the same as his free and voluntary act and deed for the uses and purposes therein set forth.

IN WITNESS WHEREOF, I have hereunto set my hand and official seal the day and year last above written.

*Marjorie Hall*  
Marjorie Hall, Notary Public

