

STATE OF KANSAS  
STATE CORPORATION COMMISSION


WELL PLUGGING RECORD

OR  
FORMATION PLUGGING RECORD

Strike out upper line  
when reporting plug-  
ging off formations.

Give All Information Completely  
Make Required Affidavit  
Mail or Deliver Report to:  
Conservation Division  
State Corporation Commission  
800 Bittling Building  
Wichita, Kansas

Stafford County. Sec. 9 Twp. 21S Rge. (E) 12 (W)  
Location as "NE $\frac{1}{4}$ NW $\frac{1}{4}$ SW $\frac{1}{4}$ " or footage from lines. C SE SW NW  
Lease Owner. G. W. Keyes Drilling Co.  
Lease Name. Krueger Well No. 1  
Office Address. Ellinwood, Kansas  
Character of Well (completed as Oil, Gas or Dry Hole) Dry Hole  
Date well completed. 7-21-45 19  
Application for plugging filed. 7-21-45 19  
Application for plugging approved. 7-21-45 19  
Plugging commenced. 7-21-45 19  
Plugging completed. 7-21-45 19  
Reason for abandonment of well or producing formation. Dry Hole  
If a producing well is abandoned, date of last production. --- 19  
Was permission obtained from the Conservation Division or its agents before plugging was com-  
menced? yes

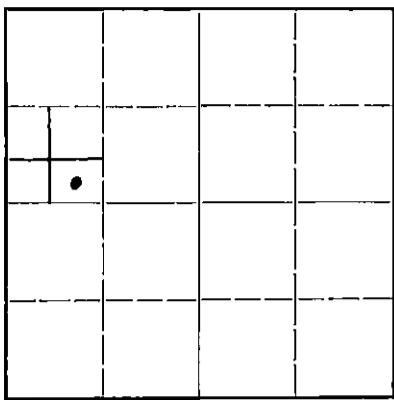

Locate well correctly on above  
Section Plat

Name of Conservation Agent who supervised plugging of this well. H. W. Kerr  
Producing formation. --- Depth to top. --- Bottom. --- Total Depth of Well. 3601 Feet  
Show depth and thickness of all water, oil and gas formations.

OIL, GAS OR WATER RECORDS


CASING RECORD

Formation	Content	From	To	Size	Put In	Pulled Out
Surface Pipe		0	350'	8 5/8	350'	none

Describe in detail the manner in which the well was plugged, indicating where the mud fluid was placed and the method or methods used in introducing it into the hold. If cement or other plugs were used, state the character of same and depth placed, from \_\_\_\_\_ feet to \_\_\_\_\_ feet for each plug set.

Hole was mudded back to 350', set bridge, cemented with 15 sacks. Hole was mudded back to within 15' of the top, set bridge, surface pipe was cut off at base of cellar, cemented with 10 sacks, cement returning to base of cellar and covering surface pipe at point where it had been cut.

PLUGGING  
FILE  
9 21 R 12W  
21 19

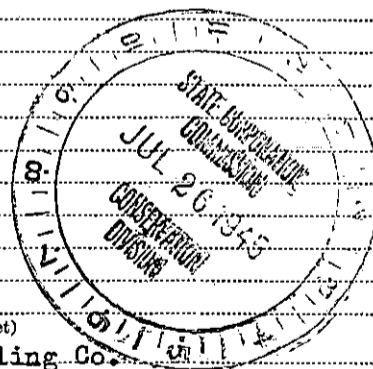

(If additional description is necessary, use BACK of this sheet)

Correspondence regarding this well should be addressed to G. W. Keyes Drilling Co.  
Address Ellinwood, Kansas

STATE OF Kansas, COUNTY OF Barton, ss.  
I, G. W. Keyes, Part Owner (employee of owner) or (owner or operator) of the above-described well,

being first duly sworn on oath, says: That I have knowledge of the facts, statements, and matters herein contained and the log of the above-described well as filed and that the same are true and correct. So help me God

(Signature)

*G. W. Keyes*

Ellinwood, Kansas  
(Address)

SUBSCRIBED AND SWORN to before me this 25 day of July, 1945

*J. J. Rader*

Notary Public.

My commission expires July 7, 1948

WELL LOG

G. W. Keyes Drilling Company, Owner - Krueger #1

C SE SW NW Section 9, Township 21 S, Range 12 W  
Stafford County, Kansas

Figures indicate bottom of formation

	0	to	290	Sand
			660	Red bed
			690	Anhydrite
Elevation	1845		880	Red bed and shale
			1150	Shale
			1285	Salt and shale
Pipe:			1520	Shale
8 5/8" set at 350 ft.			1590	Shale and lime shells
			1700	Shale and shells
			1880	Shale, shells and broken lime
			2033	Lime shells
Top Lansing	3223		2160	Shale and shells
Top Conglomerate	3457		2290	Lime, and shale and shells
Top Viola	3462		2430	Shale
Top Arbuckle	3545		2685	Shale and shells
Top Simpson	3516		2809	Shale
			2900	Shale and shells
			3190	Lime
			3223	Shale and lime
			3457	Lime
			3462	Conglomerate
			3516	Lime
			3545	Simpson
Started July 9, 1945			3601	Arbuckle lime
Abandoned Dry July 21, 1945			3601	Total Depth still in Arbuckle


State of Kansas )  
County of Barton) ss

PLUGGING  
FILE 9 21 1945  
COPY 21 19

I, G. W. Keyes, Part Owner of the above-described well, being first duly sworn on oath, declare: That I have knowledge of the facts, statements and matters herein contained pertaining to the log of the above-described well as filed and that the same are true and correct.

G. W. Keyes

Subscribed and Sworn to before me this 25th day of July, 1945.

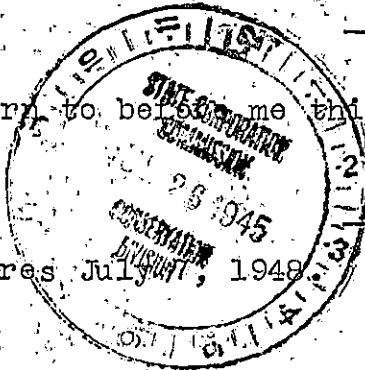

J. J. Rader

