


STATE OF KANSAS
STATE CORPORATION COMMISSION

WELL PLUGGING RECORD

Give All Information Completely
Make Required Affidavit
Mail or Deliver Report to:
Conservation Division
State Corporation Commission
800 Bitting Building
Wichita, Kansas

Stafford County, Sec. 5 Twp. 21S Rge. 12 (E) W (W)
Location as "NE/CNW $\frac{1}{4}$ SW $\frac{1}{4}$ " or footage from lines XXXXX SE SE NW
Lease Owner Alpine Oil & Royalty Co., Inc. et al
Lease Name W. O. Sieker Well No. 1
Office Address 300 Bitting Building, Wichita, Kansas
Character of Well (completed as Oil, Gas or Dry Hole) Dry Hole
Date well completed August 30, 1950
Application for plugging filed August 31, 1950
Application for plugging approved August 31, 1950
Plugging commenced August 31, 1950
Plugging completed August 31, 1950
Reason for abandonment of well or producing formation Dry Hole
If a producing well is abandoned, date of last production 19
Was permission obtained from the Conservation Division or its agents before plugging was commenced? Yes

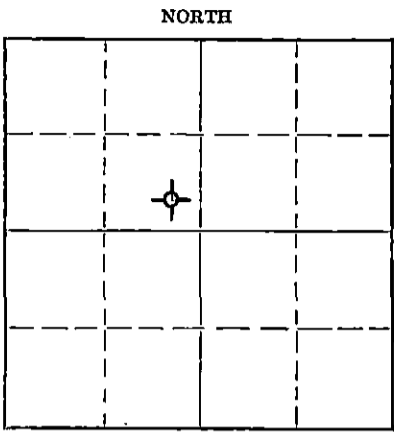

Locate well correctly on above Section Plat

Name of Conservation Agent who supervised plugging of this well C. D. Stough
Producing formation Arbuckle Depth to top 3465 Bottom 3505 Total Depth of Well 3505 Feet
Show depth and thickness of all water, oil and gas formations.

OIL, GAS OR WATER RECORDS

CASING RECORD

Formation	Content	From	To	Size	Put In	Pulled Out
				8 5/8"	283'	Cemented.

Describe in detail the manner in which the well was plugged, indicating where the mud fluid was placed and the method or methods used in introducing it into the hole. If cement or other plugs were used, state the character of same and depth placed, from _____ feet to _____ feet for each plug set.

Plugged as follows:
Heavy mud to 285'. Solid plug
and 15 sacks cement, mud to
35', plug and ten (10) sacks
cement.

9-5-50

(If additional description is necessary, use BACK of this sheet)

Correspondence regarding this well should be addressed to Alpine Oil & Royalty Co., Inc. et al
Address 300 Bitting Building, Wichita, 2, Kansas

STATE OF Kansas, COUNTY OF Sedgwick, ss.
Thomas M. McCaul (employee of owner) or (owner or operator) of the above-described well,
being first duly sworn on oath, says: That I have knowledge of the facts, statements, and matters herein contained and the log of the above-described well as filed and that the same are true and correct. So help me God.

(Signature) Thomas M. McCaul
300 Bitting Bldg., Wichita 2, Kansas
(Address)

SUBSCRIBED AND SWORN TO before me this 31st day of August, 1950.

Law Ann Allen
Notary Public.

My commission expires August 8, 1953.

PLUGGING
FILE SEC. 5121R-120
BOOK PAGE 25 LINE 9

WELL LOG

Alpine Oil & Royalty Co., Inc. et al Elevation: 1857 R.B.
 Contractor: Quaker Drilling Co., Inc. Commenced: 8-20-50
 Completed: 8-30-50
 Sieker No. 1 Production: D & A
 SE SE NW Sec. 5-21S-12W
 Stafford County, Kansas

Casing Record:

283' of 8 5/8" cemented with 225 sacks cement.

(Figures Indicate Bottom of Formations)

<u>FORMATION</u>	<u>DEPTH</u>	<u>FORMATION TOPS</u>		
Sand	230	Heebner	3072	-1215
Shale	280	Brown Lime	3196	-1339
Red Bed and Sand	535	White Lime	3217	-1360
Red Bed and Shale	656	Conglomerate	3445	-1588
Anhydrite	692	Arbuckle	3465	-1608
Shale and Shells	1130	Total Depth (Rotary)	3505	-1648
Shale and Lime	2874			
Lime	3002			
Shale and Lime	3213			
Lime	3266			
Lime and Shale	3383			
Lime	3445			
Conglomerate	3465			
Dolomite	3505			

T.D.

RECEIVED
 SEP 5 X 1950
 STATE OF KANSAS
 COMMISSIONER OF REVENUE
 KANSAS

I hereby certify that the above is a true and correct copy of Driller's Log of well drilled in the SE SE NW of 5, Township 21 South, Range 12 West, Stafford County, Kansas.

ALPINE OIL & ROYALTY CO., INC.

By: Thomas M. McCall
PresidentSubscribed and sworn to before me this 2nd day of September, 1950.Lou Ann Allen
Notary PublicMy commission expires:
August 8, 1953.

PLUGGING
 FILE SEC ST 21 R 12 W
 BOOK PAGE 25 LINE 9