


STATE OF KANSAS
STATE CORPORATION COMMISSION

WELL PLUGGING RECORD

Give All Information Completely
Make Required Affidavit
Mail or Deliver Report to:
Conservation Division
State Corporation Commission
800 Bitting Building
Wichita, Kansas

Stafford County. Sec. 5 Twp. 21S Rge. (E) 11 (W)
Location as "NE/CNW $\frac{1}{4}$ SW $\frac{1}{4}$ " or footage from lines NE NE NE
Lease Owner ALPINE OIL & ROYALTY CO., INC.
Lease Name Kasselmann Well No. 1
Office Address 300 Bitting Building Wichita, Kansas
Character of Well (completed as Oil, Gas or Dry Hole) Dry Hole
Date well completed February 14 19 51
Application for plugging filed March 5 19 51
Application for plugging approved March 6 19 51
Plugging commenced March 6 19 51
Plugging completed March 9 19 51
Reason for abandonment of well or producing formation

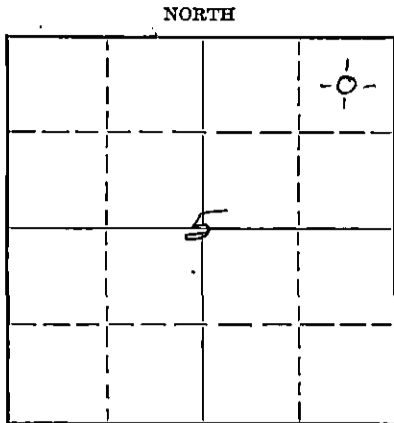

Locate well correctly on above
Section Plot

If a producing well is abandoned, date of last production 19
Was permission obtained from the Conservation Division or its agents before plugging was commenced? yes

Name of Conservation Agent who supervised plugging of this well C. D. Stough
Producing formation Arbuckle Depth to top 3432 Bottom 3480 Total Depth of Well 3480 Feet
Show depth and thickness of all water, oil and gas formations.

OIL, GAS OR WATER RECORDS

CASING RECORD

Formation	Content	From	To	Size	Put In	Pulled Out
				8 5/8"	280'	cemented

Describe in detail the manner in which the well was plugged, indicating where the mud fluid was placed and the method or methods used in introducing it into the hole. If cement or other plugs were used, state the character of same and depth placed, from feet to feet for each plug set.

Plugged back with crushed rock to 3450',
dumped 5 sax of cement at 3450' with dump
bailer. Top of cement 3415'. Filled hole
with mud to 280', set rock brudge, dumped
15 sax cement at 280'. Top of cement at
235'. Filled with mud to 30', dumped 10 sax
cement for cap.

RECEIVED
MAR 17 1951
CONSERVATION DIVISION
Wichita, Kansas

(If additional description is necessary, use BACK of this sheet)

Correspondence regarding this well should be addressed to ALPINE OIL & ROYALTY CO., INC.
Address 300 Bitting Bldg. Wichita, Kansas

STATE OF Kansas, COUNTY OF Sedgwick, ss.
Dwight J. Wilson (employee of owner) or (owner or operator) of the above-described well,
being first duly sworn on oath, says: That I have knowledge of the facts, statements and matters herein contained and the log of the above-
described well as filed and that the same are true and correct. So help me God.

(Signature) [Signature]
300 Bitting Building Wichita, Kansas
(Address)

SUBSCRIBED AND SWORN TO before me this 14th day of March 19 51

[Signature] Notary Public.

My commission expires September 14, 1953

PLUGGING
FILE SEC 5 T 21 R 11
BOOK PAGE 65 LINE 20

WELL LOG

Alpine Oil & Royalty Co., Inc.

Commenced: February 2, 1951.

Contractor: Quaker Drilling Co., Inc.

Completed: February 12, 1951

Kasselman No. 1

Production:

NE NE NE Sec. 5-21S-12W

Stafford County, Kansas

Elevation: 1852 R. B.

Casing Record:

Set 8 5/8" at 280 ' with 225 sacks of cement.

(Figures Indicate Bottom of Formations)

<u>FORMATION</u>	<u>DEPTH</u>	<u>FORMATION TOPS</u>	
Surface soil	20	Brown Lime	3174 -1322
Sand	225	Lansing	3191 -1339
Red Bed	276	Conglomerate	3421 -1569
Red Bed and Shale	607	Arbuckle	3432 -1580
Anhydrite	658	Casing	3433 -1581
Red Bed and Blue Shale	775	Total Depth	3435 -1583
Lime and Shale	2794	T. D. (cable)	3505
Lime	2865		
Lime and Shale	3421		
Conglomerate	3432		
Dolomite	3435		

RECEIVED
STATE CORPORATION COMMISSION
MAR - 6 1951
CONSERVATION DIVISION
Wichita, Kansas

I hereby certify that the above is a true and correct copy of Driller's Log of well drilled in the NE NE NE of Section 5, Township 21 South, Range 12 West, Stafford County, Kansas.

ALPINE OIL & ROYALTY CO., INC.

By: Thomas M. McLaughlin
PresidentSubscribed and sworn to before me this 5th day of March, 1951.Yashti Bell
Notary Public

My commission expires: September 14, 1953.

