


WELL PLUGGING RECORD

Give All Information Completely
Make Required Affidavit
Mail or Deliver Report to:
Conservation Division
State Corporation Commission
211 No. Broadway
Wichita, Kansas

NORTH

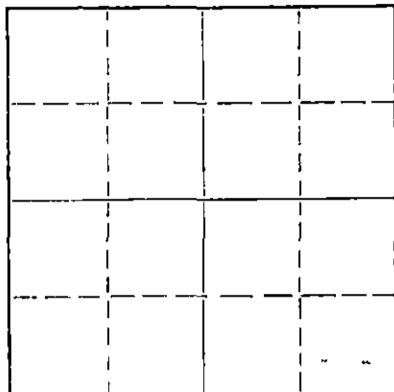

Locate well correctly on above
Section Plat

STAFFORD County. Sec. 5 Twp. 21S Rge. 12W (E) (W)
Location as "NE/CNW*SW*" or footage from lines: SW SW SE
Lease Owner ALPINE OIL & ROYALTY CO., INC.
Lease Name HAHN Well No. 1
Office Address 800 Bitting Building, Wichita, Kansas
Character of Well (completed as Oil, Gas or Dry Hole) dry hole
Date well completed April 9, 1962 19
Application for plugging filed April 9, 1962 19
Application for plugging approved April 9, 1962 19
Plugging commenced April 9, 1962 19
Plugging completed April 9, 1962 19
Reason for abandonment of well or producing formation non-productive in commercial quantities
If a producing well is abandoned, date of last production _____ 19
Was permission obtained from the Conservation Division or its agents before plugging was commenced? Yes

Name of Conservation Agent who supervised plugging of this well W. L. Lac Kamp
Producing formation _____ Depth to top _____ Bottom _____ Total Depth of Well 3566 Feet
Show depth and thickness of all water, oil and gas formations.

OIL, GAS OR WATER RECORDS

CASING RECORD

FORMATION	CONTENT	FROM	TO	SIZE	PUT IN	PULLED OUT
				8 5/8"	285'	Cemented

Describe in detail the manner in which the well was plugged, indicating where the mud fluid was placed and the method or methods used in introducing it into the hole. If cement or other plugs were used, state the character of same and depth placed, from _____ feet to _____ feet for each plug set.

Heavy mud from 3566 feet to 240 feet.
Solid plug and 20 sacks cement through drill pipe. Mud to 35 feet; another plug and 10 sacks cement; 2 sacks in rat hole

RECEIVED
STATE CORPORATION COMMISSION
4-16-62 APR 13 1962
CONSERVATION DIVISION
Wichita, Kansas

(If additional description is necessary, use BACK of this sheet)
Name of Plugging Contractor Quaker Drilling Co., Inc.
Address 800 Bitting Building, Wichita, Kansas

STATE OF Kansas, COUNTY OF Sedgwick, ss.
Thomas M. McCaul (employee of owner) or (owner or operator) of the above-described well, being first duly sworn on oath, says: That I have knowledge of the facts, statements, and matters herein contained and the log of the above-described well as filed and that the same are true and correct. So help me God.
(Signature) Thomas M. McCaul
800 Bitting Building, Wichita, Kansas (Address)

SUBSCRIBED AND SWORN TO before me this 13th day of April, 19 62
My commission expires August 10, 1965
Virginia Mundell Notary Public.



WELL LOG

WELL LOG

ALPINE OIL & ROYALTY CO., INC.

Hahn No. 1
SW SW SE Sec. 5-21S-12W
Stafford County, Kansas

Commenced: April 2, 1962

Completed: April 9, 1962

Elevation: 1850 K.B.

Production: D. & A.

Casing Record:

Set 8 5/8 inch casing at 285 feet with 275 sacks cement

(Figures Indicate the Bottom of the Formations)

<u>FORMATION</u>	<u>DEPTH</u>	<u>FORMATION TOPS</u>	
Surface Soil & Sand	230	Heebner	3063 -1213
Shale	285	Brown Lime	3192 -1342
Shells, Shale and Red Bed	648	Lansing	3209 -1359
Anhydrite	673	Base of Kansas City	3425 -1575
Shale and Shells	1290	Conglomerate	3435 -1585
Lime and Shale	1830	Arbuckle	3522 -1672
Sandy Lime and Shale	1985	Rotary Total Depth	3566 -1716
Lime and Shale	3566		

We hereby certify the foregoing to be a true and correct copy of the Driller's Log of the well drilled in the SW SW SE of Section 5, Township 21 South, Range 12 West, Stafford County, Kansas.

QUAKER DRILLING CO., INC.

By: Thomas M. McCaul
Thomas M. McCaul

SUBSCRIBED AND SWORN TO before me a Notary Public this 12th day of April, 1962.

Virginia Mundell
Virginia Mundell, Notary Public

MY COMMISSION EXPIRES:
August 10, 1965

RECEIVED
STATE CORPORATION COMMISSION
APR 11 1962
CONSERVATION DIVISION
Wichita, Kansas