


STATE OF KANSAS
STATE CORPORATION COMMISSION

WELL PLUGGING RECORD

Give All Information Completely
Make Required Affidavit
Mail or Deliver Report to
Conservation Division
State Corporation Comm.
245 North Water
Wichita, KS 67202

Stafford County, Sec. 5 Twp. 21S Rge. 12 NW
Location as "NE/CNW/SW" or footage from lines
C-E/2-NE-NE

Lease Owner L. D. Davis
Lease Name Virgil Salem "A" Well No. 1
Office Address P. O. Box 324 Great Bend, Kansas
Character of Well (Completed as Oil, Gas or Dry Hole) 67530
dry hole

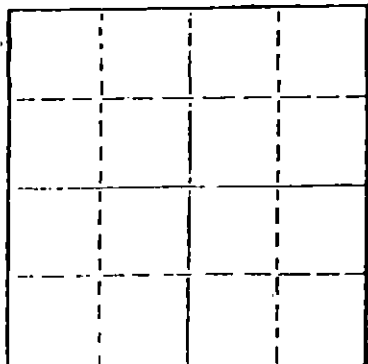

Locate well correctly on above
Section Plat

Date Well completed Feb. 13 1981
Application for plugging filed Feb. 13 1981
Application for plugging approved Feb. 13 1981
Plugging commenced 10:15 P.M. Feb. 13 1981
Plugging completed 11:15 P.M. Feb. 13 1981
Reason for abandonment of well or producing formation _____

If a producing well is abandoned, date of last production _____
19 _____

Was permission obtained from the Conservation Division or
its agents before plugging was commenced? yes

Name of Conservation Agent who supervised plugging of this well Duane Rankin
Producing formation _____ Depth to top _____ Bottom _____ Total Depth of Well 3490'
Show depth and thickness of all water, oil and gas formations.

OIL, GAS OR WATER RECORDS

CASING RECORD

FORMATION	CONTENT	FROM	TO	SIZE	PUT IN	PULLED OUT

Describe in detail the manner in which the well was plugged, indicating where the mud fluid was placed and the method or methods used in introducing it into the hold. If cement or other plugs were used, state the character of same and depth placed, from _____ feet to _____ feet for each plug set.

40 sx. at 480'
25 sx. at 275'
10 sx. at 40'
5 sx. in rat hole

(If additional description is necessary, use BACK of this sheet)

Name of Plugging Contractor _____

STATE OF Kansas COUNTY OF Barton, ss.
Don Popp (employee of owner) or (~~owner or operator~~)

of the above-described well, being first duly sworn on oath, says: That I have knowledge of the facts, statements, and matters herein contained and the log of the above-described well as filed and that the same are true and correct. So help me God.

(Signature)

Don Popp
Don Popp Holsington, Kansas
(Address)

SUBSCRIBED AND SWORN TO before me this 20th day of February, 19 81

Bessie M. DeWerff
Bessie M. DeWerff Notary Public.

My commission expires 5-20-81

BESSIE M. DEWERFF
STATE NOTARY PUBLIC
BARTON COUNTY, KANSAS
MY APPT. EXP. 5-20-81

FEB 25 1981
CONS. DIVISION
Wichita, Kansas
2-25-81

DRILLERS WELL LOG

L. D. DRILLING, INC. - CONTRACTOR

L. D. DAVIS - OPERATOR

VIRGIL SALEM "A" 1
C-E/2-NE-NE
Sec. 5-21-12
Stafford County, Kans.

T.D. 3490'
ELEV. 1861 K.B.

COMMENCED: 2-8-81
COMPLETED: 2-13-81

Casing

8 5/8" set at 273'

Cement

W/250 sx. 50/50 Pozmix, 2% Gel 3% CC

FORMATION

Sand
Red Bed
Anhy.
Shale & Shells
Shale & Lime
Lime & Shale

DEPTH

0 - 273
273 - 646
646 - 678
678 - 980
980 - 1585
1585 - 3490

FORMATION TOPS

Anhy	646-678	+1215
Heebner	3062	-1201
Toronto	3085	-1224
Douglas	3097	-1236
Brown Lime	3190	-1329
Lansing	3205	-1344
Base K/C	3432	-1571
Shaley Cong.	3444	-1583
No Arbuckle		
R.T.D.	3490	

STATE RECEIVED
FEB 25 1981
CONSULTING DIVISION
Wichita, Kansas

STATE OF KANSAS }
COUNTY OF BARTON } ss

I certify that this is a true and correct copy of the above log to the best of my knowledge.

L. D. DRILLING, INC.

Don Popp
Don Popp

Sworn to and subscribed before me this 20th day of February, 1981.

My appointment expires: 5-20-81

Bessie M. DeWerff
Bessie M. DeWerff, Notary Public

BESSIE M. DEWERFF
STATE NOTARY PUBLIC
BARTON COUNTY, KANSAS
MY APPT. EXP. 5-20-81