


STATE OF KANSAS
STATE CORPORATION COMMISSION

Form CP-4

WELL PLUGGING RECORD

Give All Information Completely
Make Required Affidavit
Mail or Deliver Report to:
Conservation Division
State Corporation Commission
212 No. Market
Wichita, Kansas

NORTH

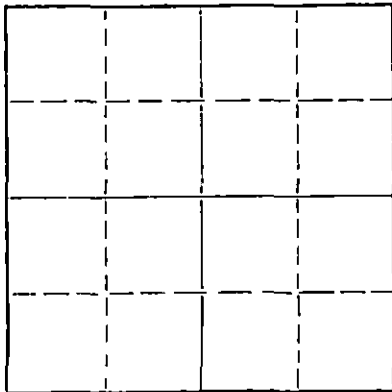

Locate well correctly on above
Section Plat

Stafford County. Sec. 5 Twp 21S Rge. (E) 12W(W)
Location as "NE/CNW/SW" or footage from lines. NE SW SE
Lease Owner Circle Oil Company, Inc.
Lease Name HAHN "B" Well No. 1
Office Address 500 Bitting Building, Wichita, Kansas
Character of Well (completed as Oil, Gas or Dry Hole) Dry Hole
Date well completed August 21, 19 66
Application for plugging filed 19
Application for plugging approved 19
Plugging commenced August 21, 19 66
Plugging completed August 21, 19 66
Reason for abandonment of well or producing formation _____

If a producing well is abandoned, date of last production 19
Was permission obtained from the Conservation Division or its agents before plugging was commenced? Yes (Archie Elving)

Name of Conservation Agent who supervised plugging of this well _____
Producing formation _____ Depth to top _____ Bottom _____ Total Depth of Well 3505 Feet
Show depth and thickness of all water, oil and gas formations.

OIL, GAS OR WATER RECORDS

CASING RECORD

| FORMATION | CONTENT | FROM | TO | SIZE | PUT IN | PULLED OUT |
|-----------|---------|------|------|--------|---------|------------|
| | Surface | 0 | 259' | 8-5/8" | 8/15/66 | ---- |
| | Casing | | | | | |
| | | | | | | |
| | | | | | | |
| | | | | | | |
| | | | | | | |

Describe in detail the manner in which the well was plugged, indicating where the mud fluid was placed and the method or methods used in introducing it into the hole. If cement or other plugs were used, state the character of same and depth placed, from _____ feet to _____ feet for each plug set.

Heavy Mud from Total Depth to 240 Feet. HOWCO Plug & Hull Plug with 25 sacks of cement thru the drill pipe; Mud to 40 feet; Plug and hulls bridged and 10 sacks of cement to base of cellar; 2 sacks cement in rat hole. Job completed at 6 A.M.

RECEIVED
STATE CORPORATION COMMISSION
AUG 24 1966

CONSERVATION DIVISION
Wichita, Kansas
8-24-66

(If additional description is necessary, use BACK of this sheet)
Name of Plugging Contractor Sage Drilling Co., Inc.
Address 500 Bitting Building, Wichita, Kansas

STATE OF KANSAS COUNTY OF SEDGWICK ss.
Thomas M. McCaul, Jr. (employee of owner) or (owner or operator) of the above-described well, being first duly sworn on oath, says: That I have knowledge of the facts, statements, and matters herein contained and the log of the above-described well as filed and that the same are true and correct. So help me God.
(Signature) [Signature]
500 Bitting Building, Wichita, Kansas
(Address)

SUBSCRIBED AND SWORN to before me this 22nd day of August, 1966
Louise K. Whitted
Louise K. Whitted - Notary Public.

My commission expires November 26, 1966

DRILLERS LOGHAHN "B" NO. 1

| | | |
|-----------------------------------|-------------------------------|---|
| CASING RECORD: | COMPANY: Circle Oil Co., Inc. | DESCRIPTION: |
| 8-5/8" @ 259' w/225 sax cement | CONTRACTOR: Sage Drilling Co. | NE SW SE Sec. 5-21S-12W, Stafford Co., Kansas |
| TOTAL DEPTH: 3505' | COMMENCED: August 15, 1966 | ELEVATION: 1850KB |
| | COMPLETED: August 21, 1966 | |

| <u>FORMATION</u> | <u>FROM</u> | <u>TO</u> | <u>REMARKS</u> |
|---------------------|-------------|-----------|----------------|
| Surface Soil & Sand | 0 | 30 | |
| Sand | 30 | 220 | |
| Shale | 220 | 261 | |
| Red Bed | 261 | 643 | |
| Anhydrite | 643 | 665 | |
| Shale | 665 | 1385 | |
| Lime & Shale | 1385 | 2080 | |
| Shale & Lime | 2080 | 2820 | |
| Lime | 2820 | 2965 | |
| Lime & Shale | 2965 | 3435 | |
| Shale & Lime | 3435 | 3485 | |
| Lime | 3485 | 3505 | |

RECEIVED
STATE CORPORATION COMMISSION
AUG 24 1966
CONSERVATION DIVISION
Wichita, Kansas

I certify that this is a true and correct copy of the above log to the best of my knowledge.

SAGE DRILLING COMPANY, INC.

By

Thomas M. McCaul, Jr.
Thomas M. McCaul, Jr.

Subscribed and sworn to before me this 22nd day of August, 1966.

Louise K. Whitted
Louise K. Whitted, Notary Public

My commission expires:
November 26, 1966.