


STATE OF KANSAS
STATE CORPORATION COMMISSION

Form CP-4

Give All Information Completely
Make Required Affidavit
Mail or Deliver Report to:
Conservation Division
State Corporation Commission

WELL PLUGGING RECORD

P. O. Box 17027
Wichita, Kansas 67217
NORTH

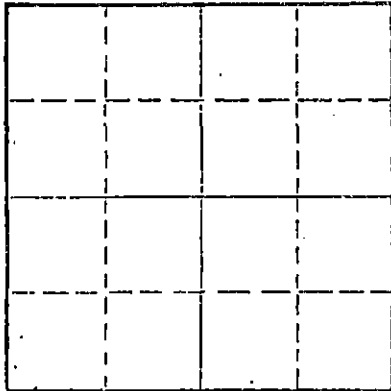

Locate well correctly on above
Section Plat

Stafford County, Sec. 13 Twp. 21S Rge. 12W (E) (W)
Location as "NE/CNWSW" or footage from lines NE/4
Lease Owner J. K. Fortner
Lease Name Eveleigh #1 Well No.
Office Address Ellinwood, Kansas 67526
Character of Well (completed as Oil, Gas or Dry Hole)
Date well completed 19
Application for plugging filed 19
Application for plugging approved 19
Plugging commenced 1/5/73 19
Plugging completed 1/15/73 19
Reason for abandonment of well or producing formation depleted.

If a producing well is abandoned, date of last production 19
Was permission obtained from the Conservation Division or its agents before plugging was commenced? yes

Name of Conservation Agent who supervised plugging of this well Biberstein
Producing formation Depth to top Bottom Total Depth of Well 3414' Feet
Show depth and thickness of all water, oil and gas formations.

OIL, GAS OR WATER RECORDS

CASING RECORD

FORMATION	CONTENT	FROM	TO	SIZE	PUT IN	PULLED OUT
				8-5/8	572	none
				5 1/2"	3469	1612'

Describe in detail the manner in which the well was plugged, indicating where the mud fluid was placed and the method or methods used in introducing it into the hole. If cement or other plugs were used, state the character of same and depth placed, from feet to feet for each plug set.

Checked hole, pushed plug to 3100; dumped 5 sacks of cement.
Loaded hole, shot pipe at 1620', pulled 50 joints. Set 5 sx plug at 500'. Filled hole to 360' with water, set rock bridge and dumped 6 yards of ready mix.

PLUGGING COMPLETE.

RECEIVED
STATE CORPORATION COMMISSION

JAN 19 1973

CONSERVATION DIVISION
Wichita, Kansas

(If additional description is necessary, use BACK of this sheet)
Name of Plugging Contractor KELSO CASING PULLING
Address CHASE, KANSAS


STATE OF KANSAS, COUNTY OF RICE, ss.
R. Darrell Kelso (employee of owner) or (owner or operator) of the above-described well, being first duly sworn on oath, says: That I have knowledge of the facts, statements, and matters herein contained and the log of the above-described well as filed and that the same are true and correct. So help me God.

(Signature) R. Darrell Kelso

Chase, Kansas
(Address)

SUBSCRIBED AND SWORN to before me this 17th day of January, 1973

My commission expires

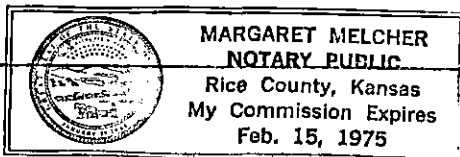

Margaret Melcher
Notary Public.