


WELL PLUGGING RECORD

Give All Information Completely
Make Required Affidavit
Mail or Deliver Report to:
Conservation Division
State Corporation Commission
800 Bitting Building
Wichita, Kansas

NORTH

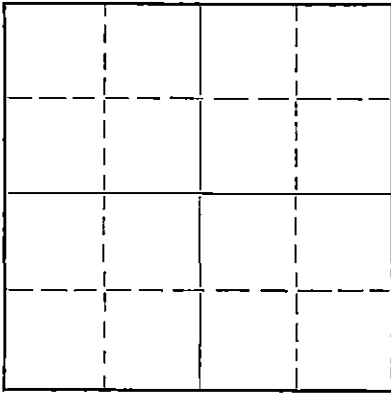

Locate well correctly on above
Section Plat

Stafford County. Sec. 13 Twp. 21 Rge. (E) 12 (W)
Location as "NE/CNW $\frac{1}{4}$ SW $\frac{1}{4}$ " or footage from lines NE/4 NE/4 SE/4
Lease Owner Hall & Prather
Lease Name Kasselmann Well No. 1
Office Address Hoisington, Kansas
Character of Well (completed as Oil, Gas or Dry Hole) Dry Hole
Date well completed May 31, 1952
Application for plugging filed May 31, 1952
Application for plugging approved May 31, 1952
Plugging commenced May 31, 1952
Plugging completed June 1, 1952
Reason for abandonment of well or producing formation Dry Hole

If a producing well is abandoned, date of last production 19
Was permission obtained from the Conservation Division or its agents before plugging was commenced? Yes

Name of Conservation Agent who supervised plugging of this well M. A. Rives, Pratt, Kansas
Producing formation Depth to top Bottom Total Depth of Well 3575 Feet
Show depth and thickness of all water, oil and gas formations.

OIL, GAS OR WATER RECORDS

CASING RECORD

Formation	Content	From	To	Size	Put In	Pulled Out
				8-5/8"	235.55'	None
				(Circulated top to bottom)		

Describe in detail the manner in which the well was plugged, indicating where the mud fluid was placed and the method or methods used in introducing it into the hole. If cement or other plugs were used, state the character of same and depth placed, from 3575 feet to 0 feet for each plug set.

Filled hole with heavy mud to 210'.
Set a bridging plug @ 210'.
Placed 1/2 sack of hulls on top of plug.
Placed 15 sacks of cement on top of hulls.
Filled hole with heavy mud to 35'.
Set a bridging plug @ 35'.
Placed 1/2 sack of hulls on top of plug.
Placed 10 sacks of cement on top of hulls to top of hole.

RECEIVED
STATE CORPORATION COMMISSION

JUN 5 - 1952 6-5-52

(If additional description is necessary, use BACK of this sheet)


Correspondence regarding this well should be addressed to Stearns Drilling Company, Kansas
Address Russell, Kansas

STATE OF KANSAS, COUNTY OF RUSSELL, ss.
O. G. Stearns (employee of owner) or (owner or operator) of the above-described well,
being first duly sworn on oath, says: That I have knowledge of the facts, statements, and matters herein contained and the log of the above-described well as filed and that the same are true and correct. So help me God.

(Signature) [Signature]
Russell, Kansas
(Address)

SUBSCRIBED AND SWORN TO before me this 4th day of June, 1952.

My commission expires June 20, 1953 [Signature] Notary Public.

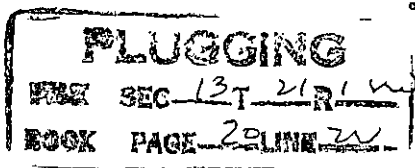

KASSELMAN #1

Operator: Hall & Prather
 Contractor: Stearns Drilling Company
 Commencement Date: May 22, 1952
 Completion Date: May 31, 1952

Location: NE/4 NE/4 SE/4 of
 Section 13-21-12, Stafford County,
 Kansas.

Elevation: 1807' D.F.

Casing Record:
 8-5/8" - 235.55' cemented w/200 sacks

WELL LOG

Clay and Sand	0	30
Sand	30	40
Sand and Shale	40	205
Red Bed	205	233
Red Bed and Shale	233	570
Anhydrite	570	590
Shale and Shells	590	1150
Salt and Shale	1150	1360
Shale and Shells	1360	1530
Lime and Shale	1530	3053
Heebner Shale	3053	3058
Lime and Shale	3058	3180
Lime	3180	3508
Simpson Shale	3508	3535
Shale and Lime	3535	3554
Lime	3554	3575
Total Depth	3575	

STATE OF KANSAS)
 COUNTY OF RUSSELL) SS

I hereby certify that the above information is true and correct to the best of my knowledge.

[Signature]

SUBSCRIBED AND SWORN to before me this 4th day of June, 1952.

My Commission Expires: June 20, 1953

[Signature]

 Notary Public
RECEIVED
 STATE CORPORATION COMMISSION
 JUN 5 - 1952
 CONSERVATION DIVISION
 Wichita, Kansas

PLUGGING
 EGCK PAGE 20 LINE 24