


WELL PLUGGING RECORD

Give All Information Completely
Make Required Affidavit
Mail or Deliver to:
Conservation Division
State Corporation Commission
212 North Market, Insurance Bldg.
Wichita, Kansas

Stafford County. Sec. 14 Twp. 21 Rge. 12w (E) (W)

Location as "NE/CNW/SW" or footage from lines NW SE NE/4
Lease Owner S. A. Murphy
Lease Name Roberts Well No. 1
Office Address 712 Brown Bldg-Wichita 2, Kansas
Character of Well (completed as Oil, Gas or Dry Hole) dry hole
Date well completed 8/5/60 19
Application for plugging filed 19
Application for plugging approved " 19
Plugging commenced " 19
Plugging completed " 19
Reason for abandonment of well or producing formation

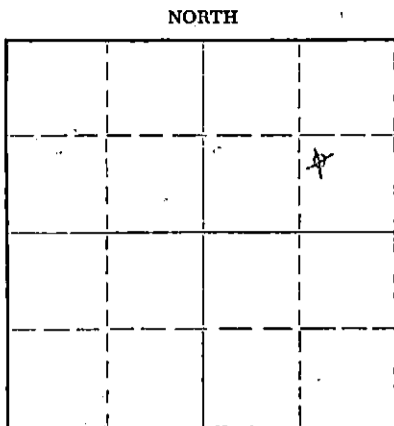

Locate well correctly on above Section Flat

If a producing well is abandoned, date of last production 19
Was permission obtained from the Conservation Division or its agents before plugging was commenced? yes

Name of Conservation Agent who supervised plugging of this well Frank Broadfoot
Producing formation Depth to top Bottom Total Depth of Well 3580 Feet
Show depth and thickness of all water, oil and gas formations.

OIL, GAS OR WATER RECORDS

CASING RECORD

FORMATION	CONTENT	FROM	TO	SIZE	PUT IN	PULLED OUT
		0	268	8 5/8"	268	none

Describe in detail the manner in which the well was plugged, indicating where the mud fluid was placed and the method or methods used in introducing it into the hole. If cement or other plugs were used, state the character of same and depth placed, from feet to feet for each plug set.

Mudded to 240 ft - set plug w/ 20 sx cement 1/4 sx hulls
" 35 ft - set plug w/ 10 sx cement 1/4 sx hulls

RECEIVED
STATE CORPORATION COMMISSION

AUG 16 1960

CONSERVATION DIVISION
Wichita, Kansas

(If additional description is necessary, use BACK of this sheet)

Name of Plugging Contractor Virginia Drilling Co Inc.
Address 712 Brown Bldg. - Wichita 2, Kansas

STATE OF Kansas COUNTY OF Stafford, ss.
S. A. Murphy (employee of owner) or (owner or operator) of the above-described well, being first duly sworn on oath, says: That I have knowledge of the facts, statements, and matters herein contained and the log of the above-described well as filed and that the same are true and correct. So help me God.

(Signature) *S. A. Murphy*
712 Brown Bldg-Wichita 2, Kansas
(Address)

SUBSCRIBED AND SWORN TO before me this 15th day of August, 1960

Mable Sawyer
Notary Public.

My commission expires Febr. 5, 1961.

ROBERTS #1 - NW SE NE/4 Section 14-21-12 Stafford County, Kansas
 Company - S. A. Murphy
 Contractor - Virginia Drilling Co., Inc.
 Commenced - Rotary July 27, 1960
 Completed - August 5, 1960
 Elevation - 1827 KB
 Total Depth - 3580

8-5/8" set at 268 w/240 sz cem.
 2% cc 3% gel

FORMATION	DEPTH	TOPS:
Sand	0-210	
Redbed	210-250	
Shale	250-1195	
Shale-shells	1195-1440	3071 - Heebner
Shale-lime	1440-1495	3103 - Douglass
Lime	1495-1965	3205 - Iatan
Lime-shale	1965-2797	3218 - Lansing
Lime	2797-3067	3441 Base KC
Shale-lime	3067-3209	3459 - Cong.
Lime	3209-3475	3522 - Viola chert
Shale-lime	3475-3580 TD	3532 - Simpson (Detrital)

S. A. Murphy
 S. A. Murphy

Subscribed and sworn to before me, a Notary Public,
 this 15th day of August, 1960.

Wesley Hawley
 Notary Public

My commission expires: Febr. 5, 1961.

RECEIVED
 STATE CORPORATION COMMISSION

AUG 16 1960

CONSERVATION DIVISION
 Wichita, Kansas