

STATE OF KANSAS
STATE CORPORATION COMMISSION

Give All Information Completely
Make Required Affidavit
Mail or Deliver Registered
Conservation Division
State Corporation Commission
211 No. Broadway
Wichita, Kansas

WELL PLUGGING RECORD

Stafford County, Sec. 14 Twp. 21S Rge. (E) 12 (W)

Location as "NE/CNW/SW" or footage from lines C S/2 NW NW

Lease Owner S. A. Murphy

Lease Name Grow "B" Well No. 1

Office Address 712 Brown Building, Wichita, Kansas

Character of Well (completed as Oil, Gas or Dry Hole) dry hole

Date well completed _____ 19 _____

Application for plugging filed August 25 19 65

Application for plugging approved _____ 19 _____


Plugging commenced August 26 19 65

Plugging completed August 30 19 65

Reason for abandonment of well or producing formation _____

If a producing well is abandoned, date of last production _____ 19 _____

Was permission obtained from the Conservation Division or its agents before plugging was commenced? yes

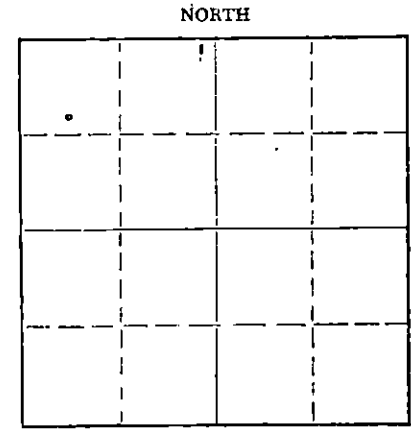

Name of Conservation Agent who supervised plugging of this well Archie V. Elving

Producing formation _____ Depth to top _____ Bottom _____ Total Depth of Well 3567 Feet

Show depth and thickness of all water, oil and gas formations.

OIL, GAS OR WATER RECORDS

CASING RECORD

FORMATION	CONTENT	FROM	TO	SIZE	PUT IN	PULLED OUT
		0	285'	8 5/8"	285'	none
		0	3531'	4 1/2"	3531'	3118.87

Describe in detail the manner in which the well was plugged, indicating where the mud fluid was placed and the method or methods used in introducing it into the hole. If cement or other plugs were used, state the character of same and depth placed, from _____ feet to _____ feet for each plug set.

Pushed plug to 3317', set 10' rock bridge and dumped 3 sacks of cement.

Bailed hole down to 200'. Set wood and 10' rock bridge. Dumped 25 sacks of cement. Filled hole with mud to 40', set 10' rock bridge and dumped 10 sacks of cement.

RECEIVED
STATE CORPORATION COMMISSION

SEP 8 1965
9-8-65
CONSERVATION DIVISION
Wichita, Kansas

(If additional description is necessary, use BACK of this sheet)

Name of Plugging Contractor Pipe Pullers, Inc.

Address Box 486, Ellinwood, Kansas

STATE OF Kansas, COUNTY OF Barton, ss.
Dean Wells (employee of owner) or (~~owner or operator~~) of the above-described

well, being first duly sworn on oath, says: That I have knowledge of the facts, statements, and matters herein contained and the log of the above-described well as filed and that the same are true and correct. So help me God.

(Signature) Dean Wells

Ellinwood, Kansas

(Address)

SUBSCRIBED AND SWORN TO before me this 7th day of September, 19 65

J. Rader
Notary Public.

My commission expires July 7, 1968

15.185.19485.0000

GROW "B" # 1 - C S/2 NW NW Sec. 14-21s-12w Stafford County, Kansas
Company - S. A. Murphy
Contractor - Virginia Drilling Co., Inc.
Commenced - Sept. 3, 1964
Completed Rotary tools - Sept. 11 - Cable tools - Sept. 27, 1964
Elevation - KB 1832, 1829 DF
Total Depth - 3551 1/2

8.5/8" set at 285 w/275 sx.
4 1/2" set at 3530 w/75 sx

FORMATION ----- DEPTH -----

Sand	0-210
Shale-shells	210-285
Redrock	285-622
Anhydrite	622-655
Shale-shells	655-1650
Lime-shale	1650-2245
Shale-shells	2245-2655
Lime-shale	2655-3323
Lime	3323-3390
Lime-shale	3390-3525
Sand	3525-3529
Arbuckle	3529-3551 1/2 TD

TOPS:

622	-	Anhydrite
3088	-	Heebner
3109	-	Toronto
3120	-	Douglas
3226	-	Brn lime
3236	-	Lansing
3456	-	Base KC
3470	-	Conglomerate
3479	-	Simpson shale
3525	-	Simpson sand
3527	-	Arbuckle

S. A. Murphy

S. A. Murphy

Subscribed and sworn to before me, a Notary Public, this 30th day of Septmeber, 19 64.

Walter H. ...

Notary Public

My commission expires: 2-5-65

RECEIVED
STATE CORPORATION COMMISSION

SEP 8 1965

CONSERVATION DIVISION
Wichita, Kansas