

KANSAS
ON COMMISSION
completely
avit
Report to:
Conservation Division
State Corporation Commission
212 North Market, Insurance Bldg.
Wichita, Kansas

WELL PLUGGING RECORD

Stafford County, Sec. 14 Twp. 21S Rge. (E) 12(W)

Location as "NE/CNW/SW" or footage from lines NW SW NE

Lease Owner CHIEF DRILLING CO., INC.

Lease Name GROW Well No. 2

Office Address P.O. Box 97, Great Bend, Kansas

Character of Well (completed as Oil, Gas or Dry Hole) Dry Hole

Date well completed 7/23/ 19 60

Application for plugging filed 7/23/ 19 60

Application for plugging approved 7/23/ 19 60


Plugging commenced 7/23/ 19 60

Plugging completed 7/23/ 19 60

Reason for abandonment of well or producing formation dry hole

If a producing well is abandoned, date of last production 19

Was permission obtained from the Conservation Division or its agents before plugging was commenced? YES

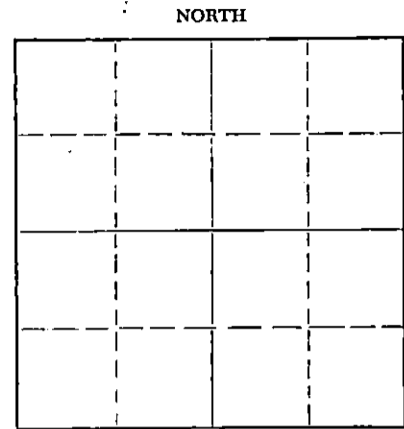

Locate well correctly on above Section Plat

Name of Conservation Agent who supervised plugging of this well Frank Broadfoot, St. John, Kansas

Producing formation Depth to top Bottom Total Depth of Well 3605 Feet

Show depth and thickness of all water, oil and gas formations.

OIL, GAS OR WATER RECORDS

CASING RECORD

FORMATION	CONTENT	FROM	TO	SIZE	PUT IN	PULLED OUT
				8 5/8"	253'	None

Describe in detail the manner in which the well was plugged, indicating where the mud fluid was placed and the method or methods used in introducing it into the hole. If cement or other plugs were used, state the character of same and depth placed, from feet to feet for each plug set.

1/3 sx hulls and wooden plug set @ 240'
Mixed 20 sx cement thru drill pipe
1/3 sx hulls and wooden plug set @ 35'
Mixed 10 sx cement.

RECEIVED
STATE CORPORATION COMMISSION

AUG 3 1960

CONSERVATION DIVISION
WICHITA, KANSAS

8-3-60

(If additional description is necessary, use BACK of this sheet)

Name of Plugging Contractor CHIEF DRILLING CO., INC.

Address P.O. Box 97m Great Bend, Kansas

STATE OF KANSAS, COUNTY OF BARTON, ss.

V. Richard Hoover - President (employee of owner) or (owner or operator) of the above-described well, being first duly sworn on oath, says: That I have knowledge of the facts, statements, and matters herein contained and the log of the above-described well as filed and that the same are true and correct. So help me God.

(Signature) *V. Richard Hoover*
V. Richard Hoover - President
P. O. Box 97, Great Bend, Kansas
(Address)

SUBSCRIBED AND SWORN TO before me this 25th day of July, 19 60

Dorothy B. John
Dorothy B. John Notary Public.

My commission expires June 18, 1963

WELL LOG

Chief Drilling Co., Inc.
P.O. Box 97
Great Bend, Kansas

No. 2 Grow
NW SW NE Sec. 14-21S-12W
Stafford County, Kansas

Contractor: Chief Drilling Co., Inc.

Commenced: 7/15/60
Completed: 7/23/60
D&A

RECEIVED
STATE CONSERVATION COMMISSION
AUG 3 1960
CONSERVATION DIVISION
Wichita, Kansas

Casing Record: 8 5/8" @ 253' cemented with 300 sacks pozmix cement.

<u>FORMATION</u>	<u>From</u>	<u>To</u>	<u>ELEVATION</u>
Sand & Shale	0	253	1828' Gr.
Redbed & Sand	253	445	1831' D.F.
Redbed & Shale	445	614	1833' K.B.
Anhydrite	614	635	
Shale & Shells	635	1520	
Shale w/Lime Streaks	1520	1630	
Lime & Shale	1630	2250	
Shale w/Lime	2250	2905	
Lime	2905	3100	
Shale	3100	3214	
Lime	3214-	3451	
Shale & Lime	3451	3486	
Conglomerate	3486	3605	
Total Depth	3605		

<u>FORMATION TOPS</u>	
Anhydrite	614 (+1219)
Heebner	3078 (-1245)
Brown Lime	3214 (-1381)
Lansing	3228 (-1395)
Base Kansas City	3451 (-1618)
Conglomerate	3486 (-1653)
Total Depth	3605 (-1772)

STATE OF KANSAS)
(SS
COUNTY OF BARTON)

I hereby certify that the above is a true and correct copy of the Driller's Log of the well drilled in the NW SW NE Sec. 14-21S-12W, Stafford County, Kansas, to the best of my knowledge and belief.

CHIEF DRILLING CO., INC.

V. Richard Hoover
V. Richard Hoover - President

Subscribed and sworn to before me this 25th day of July, 1960.

My commission expires:
6/18/63

Dorothy B. John
Dorothy B. John - Notary Public.