


Give All Information Completely  
Make Required Affidavit  
Mail or Deliver Report to:  
Conservation Division  
State Corporation Commission  
211 No. Broadway  
Wichita, Kansas

WELL PLUGGING RECORD

NORTH

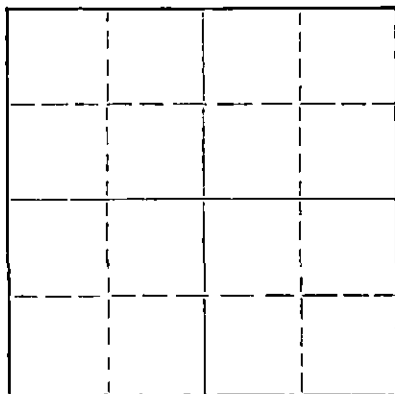

Locate well correctly on above  
Section Plat

Stafford County. Sec. 14 Twp. 21S Rge. (E) 12 (W)  
Location as "NE/CNW/SW" or footage from lines LSW NE NE  
Lease Owner CHIEF DRILLING CO., INC.  
Lease Name ROBERTS Well No. 1  
Office Address P.O. Box 97, Great Bend, Kansas  
Character of Well (completed as Oil, Gas or Dry Hole) dry hole  
Date well completed 8/21/60 19  
Application for plugging filed 8/21/60 19  
Application for plugging approved 8/21/60 19  
Plugging commenced 8/21/60 19  
Plugging completed 8/21/60 19  
Reason for abandonment of well or producing formation dry hole

If a producing well is abandoned, date of last production 19  
Was permission obtained from the Conservation Division or its agents before plugging was commenced? yes

Name of Conservation Agent who supervised plugging of this well Frank Broadfoot - St. John, Kansas  
Producing formation Depth to top Bottom Total Depth of Well 3610 Feet  
Show depth and thickness of all water, oil and gas formations.

OIL, GAS OR WATER RECORDS

CASING RECORD

FORMATION	CONTENT	FROM	TO	SIZE	PUT IN	PULLED OUT
				8-5/8"	257'	None

Describe in detail the manner in which the well was plugged, indicating where the mud fluid was placed and the method or methods used in introducing it into the hole. If cement or other plugs were used, state the character of same and depth placed, from feet to feet for each plug set.

1/3 sx hulls and wooden plug set at 240'  
Mixed 20 sx cement through drill pipe

1/3 sx hulls and wooden plug set at 35'  
Mixed 10 sx cement

STATE CORPORATION COMMISSION  
SEP 8 1960  
CONSERVATION DIVISION  
Wichita, Kansas

(If additional description is necessary, use BACK of this sheet)

Name of Plugging Contractor CHIEF DRILLING CO., INC.  
Address P.O. Box 97, Great Bend, Kansas

STATE OF KANSAS, COUNTY OF BARTON, ss.  
V. Richard Hoover (owner or operator) of the above-described well, being first duly sworn on oath, says: That I have knowledge of the facts, statements, and matters herein contained and the log of the above-described well as filed and that the same are true and correct. So help me God.

(Signature) V. Richard Hoover  
P.O. Box 97, Great Bend, Kansas  
(Address)

SUBSCRIBED AND SWORN TO before me this 24th day of August, 19 60

Dorothy B. John  
Notary Public.

My commission expires June 18, 1963



WELL LOG

Chief Drilling Co., Inc.  
P.O. Box 97  
Great Bend, Kansas

#1 Roberts  
SW NE NE Sec. 14-21S-12W  
Stafford County, Kansas

Contractor: Chief Drilling Co., Inc.

Commenced: 8-12-60  
Completed: 8-21-60  
D&A

STATE CONSERVATION COMMISSION  
SEP 8 1960  
CONSERVATION DIVISION  
Wichita, Kansas

Casing Record: 8 5/8" at 259' with 290 sx pozmix

<u>FORMATION</u>	<u>From</u>	<u>To</u>	<u>ELEVATION</u>
Sand & Gravel	0	155	1824' Gr.
Sand	155	257	1826' D.F.
Redbed	257	400	1829' K.B.
Sand	400	415	
Redbed & Shale	415	596	
Anhydrite	596	621	
Shale	621	640	
Shale & Shells	640	1550	
Hard Shells & Shale	1550	1610	
Lime & Shale	1610	2185	
Shale & Lime	2185	2740	
Lime	2740	3068	
Shale & Lime	3068	3101	
Shale	3101	3202	
Lime	3202	3442	
Cherty Lime & Shale	3442	3474	
Chert & Shale	3474	3490	
Chert	3490	3527	
Shale	3527	3551	
Dolomite	3551	3610	
Total Depth	3610		

<u>FORMATION TOPS</u>	
Anhydrite	596 (+1233)
Heebner	3068 (-1239)
Toronto	3087 (-1258)
Brown Lime	3200 (-1373)
Lansing	3215 (-1386)
Base Kansas City	3442 (-1613)
Conglomerate	3474 (-1645)
Viola	3490 (-1661)
Simpson	3527 (-1698)
Arbuckle	3551 (-1722)
Total Depth	3610 (-1781)

STATE OF KANSAS, COUNTY OF BARTON) SS

I hereby certify that the above is a true and correct copy of the Driller's Log of the well drilled in the SW NE NE Sec. 14-21S-12W, Stafford County, Kansas, to the best of my knowledge and belief.

CHIEF DRILLING CO., INC.

*V. Richard Hoover*  
V. Richard Hoover - President

Subscribed and sworn to before me this 24th day of August, 1960.

My commission expires 6/18/63

*Dorothy B. John*  
Dorothy B. John, Notary Public