


STATE OF KANSAS  
STATE CORPORATION COMMISSION

WELL PLUGGING RECORD

Give All Information Completely  
Make Required Affidavit  
Mail or Deliver Report to:  
Conservation Division  
State Corporation Commission  
211 No. Broadway  
Wichita, Kansas

NORTH

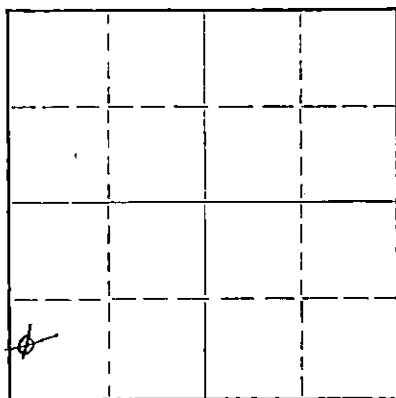

Locate well correctly on above  
Section Plat

Stafford County. Sec. 11 Twp. 21 Rge. 12 (W)  
Location as "NE/CNW/SW" or footage from lines W/2 SW SW  
Lease Owner Virginia Drilling Co., Inc.  
Lease Name Roberts Well No. #2  
Office Address 712 Brown Bldg., Wichita, Kansas  
Character of Well (completed as Oil, Gas or Dry Hole) \_\_\_\_\_  
Date well completed 8-14-56 19\_\_\_\_  
Application for plugging filed Yes 19\_\_\_\_  
Application for plugging approved Yes 19\_\_\_\_  
Plugging commenced 7-9 19 58  
Plugging completed 7-14 19 58  
Reason for abandonment of well or producing formation Not enough oil to pay

If a producing well is abandoned, date of last production May 4 1958  
Was permission obtained from the Conservation Division or its agents before plugging was commenced? Yes

Name of Conservation Agent who supervised plugging of this well Mr. Frank Broadfoot  
Producing formation \_\_\_\_\_ Depth to top \_\_\_\_\_ Bottom \_\_\_\_\_ Total Depth of Well 3602' Feet  
Show depth and thickness of all water, oil and gas formations.

OIL, GAS OR WATER RECORDS

CASING RECORD

FORMATION	CONTENT	FROM	TO	SIZE	PUT IN	PULLED OUT
				8 5/8"		
				5 1/2"		2,807'

Describe in detail the manner in which the well was plugged, indicating where the mud fluid was placed and the method or methods used in introducing it into the hole. If cement or other plugs were used, state the character of same and depth placed, from \_\_\_\_\_ feet to \_\_\_\_\_ feet for each plug set.

Measured into T.D. 3602'.  
Plugging started 7-9-58. Finished 7-14-58.  
Plugged off bottom with sand to 3540' and dumped 5 sacks cement.  
Shot 5 1/2" casing at 2,807'. Spotted oil. Pulled pipe out of hole and plugged well as follows: Mudded to 300'. Set rock bridge and dumped 20 sacks cement. Filled hole with mud to 40'. Set rock bridge and mixed 10 sacks cement for cap on well. Well completed.

(If additional description is necessary, use BACK of this sheet)

Name of Plugging Contractor J.O. Forbes d/b/a Forbes Casing Pulling Co.  
Address Box 221, Great Bend, Kansas

STATE OF Kansas, COUNTY OF Great Bend, ss.  
J.O. Forbes (employee of owner) or (owner or operator) of the above-described well, being first duly sworn on oath, says: That I have knowledge of the facts, statements, and matters herein contained and the log of the above-described well as filed and that the same are true and correct. So help me God.

(Signature) J.O. Forbes  
Box 221, Great Bend, Kansas (Address)

SUBSCRIBED AND SWORN to before me this 17th day of July, 1958  
Betty S. Edman Notary Public.

My commission expires November 8, 1960.

RECEIVED  
STATE CORPORATION COMMISSION

JUL 26 1958

CONSERVATION DIVISION  
Wichita, Kansas

PLUGGING  
FILE SEC 14T.21 R.12W  
BOOK PAGE 112 LINE 40

Name: Roberts #2 W/2 SW SW Sec. 14-21-12W Stafford Co., Kansas  
 Company: Virginia Drilling Co., Inc. and E. H. Adair Oil Co.  
 Contractor: Virginia Drilling Co., Inc.  
 Commenced: June 15, 1946  
 Completed: August 14, 1946  
 Total Depth: 3602'  
 Elevation: 1837'

Sand - shells	0- 220		
Shale-shells	220- 280		
Sandy shale	280- 305		
Set 15 jts. 8 5/8" casing @	315		
Shale - shells	315- 337		
Red bed - shale	337- 800		
Red rock - shale	800-990		
Shale	990-1100		
Salt-shells	1100-1205		
Salt-shales	1205-1430		
Lime-shale	1430-1775		
Lime	1775-1930	Circ for samples	3547
Lime-shale	1930-2070	" " "	3549
Lime	2070-2115	" " "	3551
Shale & lime	2115-2385		
Shale	2385-2485	Ran 5 1/2" OD - set at	3551
Shale & shells	2485-2570		
Lime	2570-2665		
Lime-shale	2665-2773	TOPS:	
Lime-broken	2773-2800		
Lime	2800-2996	Kansas City	3229
Sandy lime	2996-3025	Cherty Conglomerate	3477
Lime	3025-3190	Simpson Shale	3508
Lime-shale	3190-3265	Arbuckle	3551
Lime	3265-3435		
Shale-lime	3435-3474		
Shale	3474-3477		
Hard cherty conglomerate	3477-3510		
Shale	3510-3543		
Simpson sand	3543-3546		
Lime	3546-3551		

Now comes S. A. Murphy, who states that he is familiar with the drilling of oil and gas wells and known of his own knowledge that the Roberts #2, located in the W/2 SW/4 SW/4 of Section 14-21-12W, Stafford County, Kansas, was drilled to a total depth of 3602 feet, oil being found in the Siliceous Lime.

*S. A. Murphy*

Subscribed and sworn to before me, a Notary Public, this 29<sup>th</sup> day of October, 1946.

*Wm. E. Hartline*  
 Notary Public

My Commission expires: February 5, 1949.

RECEIVED  
 STATE CORPORATION COMMISSION

JUL 8 1958

CONSERVATION DIVISION  
 Wichita, Kansas

PLUGGING  
 FILE SEC 14 T 21 R 12W  
 BOOK PAGE 112 LINE 40