

STATE OF KANSAS
STATE CORPORATION COMMISSION

WELL PLUGGING RECORD

Give All Information Completely
Make Required Affidavit
Mail or Deliver Report to:
Conservation Division
State Corporation Commission
800 Bittling Building
Wichita, Kansas

Barton County. Sec. 17 Twp. 16 Rge. (E) 12 (W)

Location as "NE/CNW $\frac{1}{4}$ SW $\frac{1}{4}$ " or footage from lines SE SE SW

Lease Owner Derby Drilling Company

Lease Name Prosser Well No. 1

Office Address 352 No. Broadway - Wichita, Kansas

Character of Well (completed as Oil, Gas or Dry Hole) Dry Hole

Date well completed 9/8 1950

Application for plugging filed 9/13 1950

Application for plugging approved 9/11 1950


Plugging commenced 9/9 1950

Plugging completed 9/9 1950

Reason for abandonment of well or producing formation Dry

If a producing well is abandoned, date of last production - 19

Was permission obtained from the Conservation Division or its agents before plugging was commenced? Yes - in field

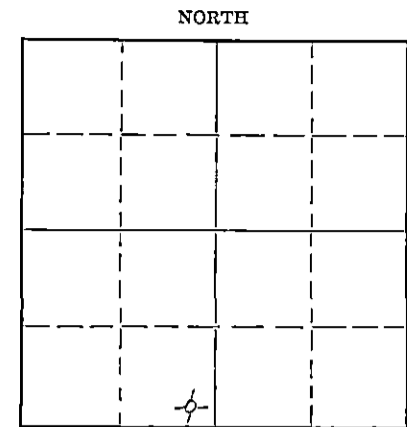

Locate well correctly on above Section Flat

Name of Conservation Agent who supervised plugging of this well Mr. C. D. Stough

Producing formation Arbuckle Depth to top T.D. in Bottom Total Depth of Well 3412 Feet

Show depth and thickness of all water, oil and gas formations. Conglomerate

OIL, GAS OR WATER RECORDS

CASING RECORD

Formation	Content	From	To	Size	Put In	Pulled Out
<u>Clay - shale & shells</u>	<u>water</u>	<u>0</u>	<u>202</u>	<u>8 7/8</u> <u>8 7/8</u>	<u>202</u>	<u>none</u>

Describe in detail the manner in which the well was plugged, indicating where the mud fluid was placed and the method or methods used in introducing it into the hole. If cement or other plugs were used, state the character of same and depth placed, from feet to feet for each plug set.

Plug set at 3412'
 Cement 15 sacks 3412' to 3362'
 Heavy mud 3362' to 36'
 Cement 10 sacks 36' to 6'
 Soil 6' to 0'

9-16-50

(If additional description is necessary, use BACK of this sheet)

Correspondence regarding this well should be addressed to Derby Drilling Company
Address 352 No. Broadway - Wichita 2, Kansas

STATE OF Kansas, COUNTY OF Sedgwick, ss.
M. S. Davis (employee of owner) or owner of the above-described well,

being first duly sworn on oath, says: That I have knowledge of the facts, statements, and matters herein contained and the log of the above-described well as filed and that the same are true and correct. So help me God.


(Signature) M. S. Davis

352 No. Broadway (Address)

SUBSCRIBED AND SWORN to before me this 13th day of September, 1950.

Harold F. Jurek
Notary Public.

My commission expires 7-19-54

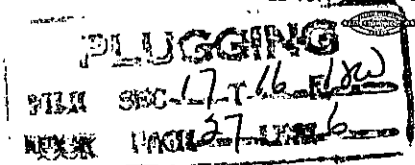

Derby Drilling Company
Production Department
Wichita, Kansas

Prosser #1
SE SE SW 1/4
17-16-12W
Barton County, Kansas

Elevation: 1901 D. F.
Spudded:
Rotary Completed:
Cable Tools Completed:
Acid Treatment:
Initial Production:
Contractor: Derby Drilling Company

CASING RECORD

202' 8 5/8" O.D. 32# Cemented with 135 sack Portland Cement.
5 1/2"

DRILLERS' LOG

Clay	0 to 40	Lime	2085 to	2215
Shale & Shells	202	Lime & Shale		2550
Shale, Shells & Sand	675	Shale		2724
Shale Red	826	Shale & Lime		2800
Anhydrite	851	Lime		3020
Shale & Shells	1490	Lime & Shale		3111
Lime & Shale	1660	Lime		3365
Shale & Shells	1800	Lime & Shale		3391
Shale & Lime	2085	Chert & Lime		3412

3412 T. D. = 3410 D. F.

STATE OF KANSAS)
SEDGWICK COUNTY) SS:

I hereby certify that to the best of my knowledge and belief, the foregoing log is true and correct.

DERBY DRILLING COMPANY

By M. L. Davis

Subscribed and sworn to before me, a Notary Public, in and for the State and County aforesaid this 14th day of September, 1950

My Commission Expires: July 19, 1954

Harold Smith
Notary Public

SEP 16 1950

PLUGGING
DATE SEP-17-1950
DECK NO. 27

SEP 16 1950
KANSAS