


Give All Information Completely
Make Required Affidavit
Make or Deliver Report to:
Conservation Division
State Corporation Commission
800 Bittling Building
Wichita, Kansas

OR
FORMATION PLUGGING RECORD

Strike out upper line
when reporting plug-
ging of formations.

NORTH

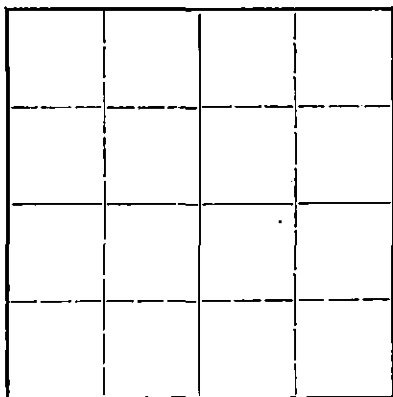

Locate well correctly on above
Section Flat

Barton County. Sec. 17. Twp. 16. Rge. 12W(E) (W)
Location as "NE $\frac{1}{4}$ NW $\frac{1}{4}$ SW $\frac{1}{4}$ " or footage from lines SW SE SE
Lease Owner Black-Marshall Oil Co
Lease Name Kultgen Well No. 1
Office Address Great Bend, Kansas.
Character of Well (completed as Oil, Gas or Dry Hole) dry-hole
Date well completed 4-26- 19 47
Application for plugging filed 4-28 19 47
Application for plugging approved 19
Plugging commenced 4-28- 19 47
Plugging completed 4-29- 19 47
Reason for abandonment of well or producing formation dry-hole

If a producing well is abandoned, date of last production 19
Was permission obtained from the Conservation Division or its agents before plugging was com-
menced? yes

Name of Conservation Agent who supervised plugging of this well W.H. Kerr
Producing formation Depth to top Bottom Total Depth of Well 3375 Feet
Show depth and thickness of all water, oil and gas formations.


OIL, GAS OR WATER RECORDS

CASING RECORD

Formation	Content	From	To	Size	Put In	Pulled Out
sand	fresh water	230'	235'	12 $\frac{1}{2}$ " csg.	446'	446'
				10" "	815'	815'
	Dakota	420'	430'	8" "	2128'	
				U.R.	2531'	2531'
				7" csg.	3129'	
				U.R.	3171'	3171'

Describe in detail the manner in which the well was plugged, indicating where the mud fluid was placed and the method or methods used in introducing it into the hold. If cement or other plugs were used, state the character of same and depth placed, from feet to feet for each plug set.

Filled hole with heavy mud to 240'-set bridge @ 240'-filled hole
with rock and cemented with 15 sks-filled hole with heavy mud to 15'-set
bridge-run 10 sks cement up into cellar.

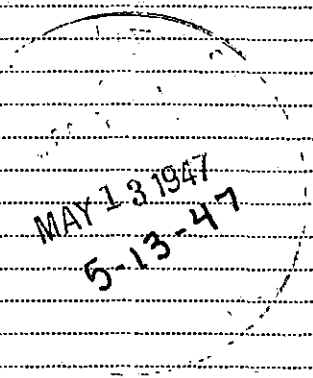

(If additional description is necessary, use BACK of this sheet)

Correspondence regarding this well should be addressed to Black-Marshall Oil Co.
Address Great Bend, Kansas.

STATE OF Kansas, COUNTY OF Barton, ss.
Walter C. Roberts (employee of owner) or (owner or operator) of the above-described well,
being first duly sworn on oath, says: That I have knowledge of the facts, statements, and matters herein contained and the log of the above-
described well as filed and that the same are true and correct. So help me God.

(Signature) Walter C Roberts
Claflin, Kansas.
(Address)

SUBSCRIBED AND SWORN to before me this 1 day of May, 1947
Edwin Wojcik Notary Public.

My commission expires Feb. 5 1951

PLUGGING
FILE SEC 17-T-16-R-12W
BOOK PAGE 108 LINE 4

