


STATE OF KANSAS
STATE CORPORATION COMMISSION

Form CP-4

WELL PLUGGING RECORD

Give All Information Completely
Make Required Affidavit
Mail or Deliver Report to:
Conservation Division
State Corporation Commission
212 No. Market
Wichita, Kansas 67202

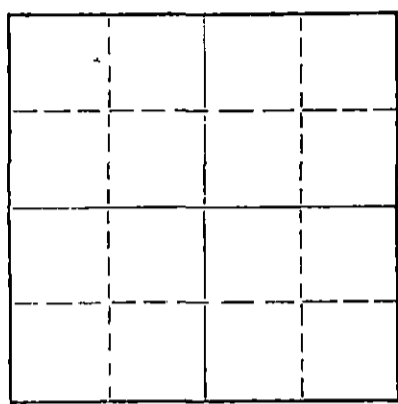

Locate well correctly on above
Section Plat

Barton County, Sec. 17 Twp. 16S Rge. 12W (W)
Location as "NE/CNW/SW" or footage from lines NW NE NW
Lease Owner ISEN ISERN-WELLS
Lease Name Anton Staudinger Well No. 1
Office Address Box 486, Ellinwood, Kansas 67526
Character of Well (completed as Oil, Gas or Dry Hole) Dry Hole
Date well completed August 30 19 70
Application for plugging filed August 30 19 70
Application for plugging approved August 30 19 70
Plugging commenced August 30 19 70
Plugging completed August 30 19 70
Reason for abandonment of well or producing formation Dry Hole

If a producing well is abandoned, date of last production _____ 19____
Was permission obtained from the Conservation Division or its agents before plugging was commenced? yes

Name of Conservation Agent who supervised plugging of this well Donald Truan, Russell, Kansas
Producing formation _____ Depth to top _____ Bottom _____ Total Depth of Well 3370 Feet
Show depth and thickness of all water, oil and gas formations.

OIL, GAS OR WATER RECORDS CASING RECORD

FORMATION	CONTENT	FROM	TO	SIZE	PUT IN	PULLED OUT
Shale		190	516,	8 / 5/8	513'	NONE

RECEIVED
STATE CORPORATION COMMISSION
SEP 1 1970
CONSERVATION DIVISION
Wichita, Kansas

Describe in detail the manner in which the well was plugged, indicating where the mud fluid was placed and the method or methods used in introducing it into the hole. If cement or other plugs were used, state the character of same and depth placed, from _____ feet to _____ feet for each plug set.

Filled hole with mud to 40' 10 sacks cement 1/2 sack bulls
Filled hole with mud to 300' 25 sacks cement thru drill pipe
Plug down at 6:00 p.m.

Name of Plugging Contractor ISERN DRILLING COMPANY
Address Box 486, Ellinwood, Kansas 67526

STATE OF KANSAS, COUNTY OF BARTON, ss.
W. F. Banks (employee of owner) or (owner or operator) of the above-described well, being first duly sworn on oath, says: That I have knowledge of the facts, statements, and matters herein contained and the log of the above-described well as filed and that the same are true and correct. So help me God.

(Signature) [Signature]
Box 486, Ellinwood, Kansas 67526
(Address)

SUBSCRIBED AND SWORN TO before me this 31st day of August, 19 70

My commission expires _____
[Signature]
Notary Public.

RECEIVED
STATE CORPORATION COMMISSION
SEP 1 1970
CONSERVATION DIVISION
Wichita, Kansas

W E L L L O G

Anton Staudinger #1
NW NE NW, Sec. 17-16S-12W
Barton County, Kansas

ELEVATION: 1891' GL; 1893' DF; 1895' KB.

Figures indicate bottom of formation:

PIPE RECORD:

8 5/8" set at 513' with
250 sacks Sunset Cement.

ROTARY COMMENCED: 8-23-70
ROTARY COMPLETED: 8-31-70


0	to	69	clay & post rock
		190	shale & shells
		516	shale
		813	red bed
		1490	shale & shells
		1885	lime & shale
		2055	lime
		2460	shale & shells
		2720	shale & lime
		2993	lime & shale
		3049	shale
		3165	lime & shale
		3240	lime
		3300	lime & shale
		3305	lime
		3340	sand
		3370	shale & lime
		3370	Rotary Total Depth

TOPS (LOG)

Anhydrite	814
Topeka	2688
Heebner	2959
Brown Lime	3048
Lansing	3063
Quartzite Sand	3294
Log Total Depth	3367

STATE OF KANSAS)
COUNTY OF BARTON) ss

I, W. F. Banks, Drilling Superintendent of Isern Drilling Company, contractor for the above-described well, being first duly sworn on oath, declare: That I have knowledge of the facts statements and matter herein contained pertaining to the log of the above-described well, as filed, and that the same are true and correct.

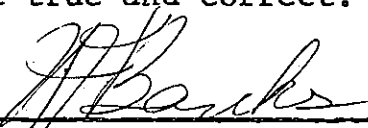

W. F. Banks

Subscribed and sworn to before me on this 31st day of August, 1970.

My commission expires:



EVELYN L. MILLER, NOTARY PUBLIC
COMMISSION EXPIRES FEB. 25, 1971

Notary Public