

15-145-01472-0000


STATE OF KANSAS
STATE CORPORATION COMMISSION

WELL PLUGGING RECORD

Give All Information Completely
Make Required Affidavit
Mail or Deliver Report to:
Conservation Division
State Corporation Commission
212 North Market, Insurance Bldg.
Wichita, Kansas

Pawnee County, Sec. 3 Twp. 23 S Rge. (E) 16 (W)
Location as "NE/CNW/SW" or footage from lines NE/4 NE/4 SW/4
Lease Owner Messman-Rinehart Oil Company
Lease Name Aldrich Well No. 2
Office Address 518 Petroleum Building, Wichita, Kansas
Character of Well (completed as Oil, Gas or Dry Hole) Oil
Date well completed May 11 19 54
Application for plugging filed September 22 19 59
Application for plugging approved September 28 19 59
Plugging commenced September 28 19 59
Plugging completed October 3 19 59
Reason for abandonment of well or producing formation Depleted reservoir

NORTH

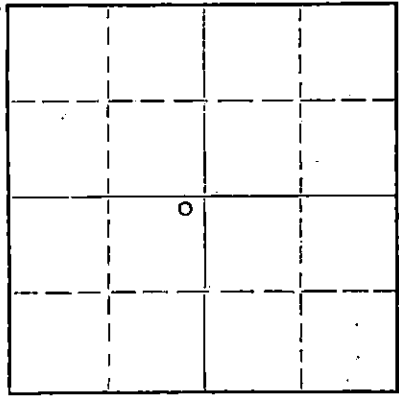

Locate well correctly on above Section Plat

If a producing well is abandoned, date of last production August 10 1959
Was permission obtained from the Conservation Division or its agents before plugging was commenced? yes

Name of Conservation Agent who supervised plugging of this well Frank Broadfoot, St. John, Kansas
Producing formation _____ Depth to top _____ Bottom _____ Total Depth of Well 4087 Feet
Show depth and thickness of all water, oil and gas formations.

OIL, GAS OR WATER RECORDS

CASING RECORD

FORMATION	CONTENT	FROM	TO	SIZE	PUT IN	PULLED OUT
				8-5/8"	228'	none
				5-1/2"	4084'	2350'

Describe in detail the manner in which the well was plugged, indicating where the mud fluid was placed and the method or methods used in introducing it into the hole. If cement or other plugs were used, state the character of same and depth placed, from _____ feet to _____ feet for each plug set.

Sand to 3980 ft., mixed and run 5 sx.
cement with dump bailer, mudded hole
with 15 sx. jel mud to 225 ft., set
10 ft. rock bridge and ran 2 sx. cal-seal
to shut off gas escaping from surf. csg.,
sq. hole with 15 sx. jell mud, set plug
at 225 ft. with 75 sx. cement to base of
cellar.

RECEIVED
STATE CORPORATION COMMISSION

FEB 12 1960
2-12-60
CONSERVATION DIVISION
Wichita, Kansas

(If additional description is necessary, use BACK of this sheet)
Name of Plugging Contractor Southwest Casing Pulling Co., Inc. - License No. 399
Address P. O. Box 364, Great Bend, Kansas

STATE OF Kansas, COUNTY OF Sedgwick, ss.
J. A. Gilliland (employee of owner) of the above-described well, being first duly sworn on oath, says: That I have knowledge of the facts, statements, and matters herein contained and the log of the above-described well as filed and that the same are true and correct. So help me God.

(Signature) J. A. Gilliland
518 Petroleum Building, Wichita, Kansas (Address)

SUBSCRIBED AND SWORN TO before me this 9th day of February, 19 60

Barbara J. Scott, Notary Public

My commission expires December 1, 1960

15-145-61472-0000

WELL RECORD

Location: NE NE SW 3-23-16W
 Pawnee County, Kansas

Operator: Graham-Messman-Rinehart Oil Company
 1005 E. 2nd St., Wichita, Kansas

Contractor: Graham-Messman-Rinehart Drilling Company
 1005 E. 2nd St., Wichita, Kansas

Casing Record: 8 5/8" @ 228' W/165 sacks cement
 5 1/2" @ 4081' W/125 sacks cement

Commenced: April 12, 1954
 Completed: April 26, 1954
 Elevation: 2053 K.B.
 Production:

LOG

Shale	25
Sand & shale	90
Shale & shells	226
Shale	340
Sand	370
Shale & red bed	486
Sand	550
Shale & red bed	1005
Anhydrite	1034
Shale & red bed	1175
Shale & shells	1490
Shale & shells	1915
Lime & shale	2015
Lime & shale	2265
Lime & shale	2575
Lime & shale	2995
Lime & shale	3300
Lime	3320
Lime & shale	3400
Lime	3656
Lime	3711
Lime - porous	3720
Lime	3913
Lime	4015
Conglomerate	4038
Conglomerate	4087 R.T.D.

RECEIVED
 STATE COMMISSION

FEB 12 1960

CONSERVATION DIVISION
 Wichita, Kansas

TOPS

Anhydrite -1005' (+ 998)
 Brown Lime-3609' (-1556)
 Lansing -3617' (-1564)
 Conglomerate -3985' (-1932)
 Simpson -4062' (-2009)
 Arbuckle -4081' (-2028)

The undersigned, GRAHAM-MESSMAN-RINEHART DRILLING COMPANY, hereby certifies that the above log is a true and correct log of the formation encountered in drilling the above well, as reflected by the Daily Drilling Reports.

GRAHAM-MESSMAN-RINEHART DRILLING COMPANY

By: J. A. Gilliland
 J. A. Gilliland

Subscribed and sworn to before me
 this 30 day of April, 1954.

Notary Public
 Notary Public

My Commission Expires: September 14, 1957

GMR
 File Copy

NO. 2 ALDRICH

NE NE SW 3, T-23-S, R-16-W
Pawnee County, Kansas

15-145-61472-6000

- May 7 Moved in Cable Tools
- May 8 Swabbed hole dry. Cleaned out to 4056'.
Perforated 12⁸, 3707-3711. Swabbing and testing 3.48 BOPH, 10%
water.
L-W Plug set at ³⁶⁹⁰3680'.
- May 9 Swabbing and testing.
- May 10 Perforated 23⁸, 3648-3656.
Acidized with 2000 gallons.
- May 11 Swabbed and Flowed 73 BOPH - 3 hours
Swabbed and Flowed 16 BOPH - 2 hours
Swabbed and Flowed 23.20 BOPH - next hour
Swabbed and Flowed 24.36 BOPH - next hour
Swabbed and Flowed 42.92 BOPH - next hour
Swabbed and Flowed 44.48 BOPH - next hour
Swabbed and Flowed 40.00 BOPH - Final Average

Waiting for State Potential

5-26-54 2254 BOPD - State Potential

GMR
File Copy