

15-009-20072-00-00

STATE OF KANSAS  
STATE CORPORATION COMMISSION

Form CP-4

Give All Information Completely  
Make Required Affidavit  
Mail or Deliver Report to:  
Conservation Division  
State Corporation Commission  
212 No. Market  
Wichita, Kansas

WELL PLUGGING RECORD

BARTON County, Sec. 17 Twp. 16s. Rgs. 12 (E) (W)

Location as "NE/CNW/SW" or footage from lines NE SW SE

Lease Owner PETROLEUM, INC.

Lease Name WEBER Well No. L-1

Office Address R.R. #2, GREAT BEND, KANSAS

Character of Well (completed as Oil, Gas or Dry Hole) DRY HOLE

Date well completed JULY 5 1967

Application for plugging filed JULY 5 1967

Application for plugging approved JULY 5 1967


Plugging commenced JULY 5 1967

Plugging completed JULY 5 1967

Reason for abandonment of well or producing formation NO PRODUCIBLE ZONE

If a producing well is abandoned, date of last production NONE 19

Was permission obtained from the Conservation Division or its agents before plugging was commenced? YES

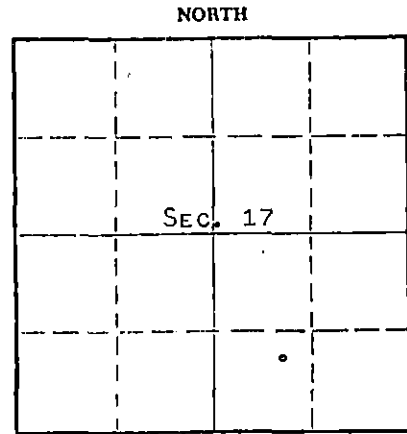

Locate well correctly on above Section Plat

Name of Conservation Agent who supervised plugging of this well DONALD TRUAN

Producing formation \_\_\_\_\_ Depth to top \_\_\_\_\_ Bottom \_\_\_\_\_ Total Depth of Well 3322 Feet

Show depth and thickness of all water, oil and gas formations.

OIL, GAS OR WATER RECORDS

CASING RECORD

FORMATION	CONTENT	FROM	TO	SIZE	PUT IN	PULLED OUT
				8-5/8"	368	NONE

Describe in detail the manner in which the well was plugged, indicating where the mud fluid was placed and the method or methods used in introducing it into the hole. If cement or other plugs were used, state the character of same and depth placed, from \_\_\_\_\_ feet to \_\_\_\_\_ feet for each plug set.

MUD TO 350', FOLLOWED BY WOODEN PLUG, 1/4 SACK HULLS; 25 SACKS CEMENT ON TOP OF PLUG. MUD TO 40', FOLLOWED BY WOODEN PLUG, 1/2 SACK HULLS, 10 SACKS CEMENT ON TOP OF PLUG TO BASE OF WELL CELLAR.

RECEIVED  
STATE CORPORATION COMMISSION

JUL 17 1967

CONSERVATION DIVISION  
Wichita, Kansas

(If additional description is necessary, use BACK of this sheet)

Name of Plugging Contractor GARVEY DRILLING CO.

Address R.R. #2, GREAT BEND, KANSAS

STATE OF KANSAS, COUNTY OF BARTON, ss.  
MONTE CHADD, (employee of owner) or (owner) of the above-described well, being first duly sworn on oath, says: That I have knowledge of the facts, statements, and matters herein contained and the log of the above-described well, as filed and that the same are true and correct. So help me God. MONTE CHADD, DIST. ROD. SUPT.

(Signature) [Signature]  
R.R. #2, GREAT BEND, KANSAS  
(Address)

SUBSCRIBED AND SWORN TO before me this 14 day of JULY, 19 67

[Signature]  
Notary Public.

My commission expires MAY 28, 1969

# WELL LOG

COMPANY Petroleum, Inc.

SEC. 17 T. 16S R. 12W

FARM Weber

NO. L-1

LOC. NE SW SE


TOTAL DEPTH 3322'

COUNTY Barton

COMM. 6-27-67

COMP. 7-5-67

CONTRACTOR Garvey Drilling Company

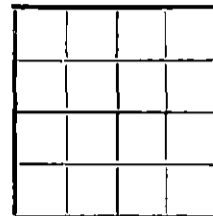

CASING 8 5/8" @ 368' w/225 SX

ELEVATION 1905' KB

PRODUCTION D & A

FIGURES INDICATE BOTTOM OF FORMATIONS

- 50' Post Rock
- 368' Shale and Shells
- 445' Shale
- 804' Shale and Shells
- 834' Anhydrite
- 1140' Shale and Shells
- 1480' Shale
- 2030' Lime and Shale
- 2962' Shale and Lime
- 2966' Heebner
- 3057' Shale with Lime
- 3315' Lime
- 3322' Sand
- 3322' RTD

**RECEIVED**  
STATE CORPORATION COMMISSION

JUL 17 1967

CONSERVATION DIVISION  
Wichita, Kansas

State of Kansas }  
County of Barton } ss

I, Sam N. Stephens of Garvey Drilling Company

upon oath state the above and foregoing is a true and correct copy of the log of the Weber L-1 well.

Subscribed and sworn to before me this 13th day of July 19 67

My Commission Expires: May 28, 1969

NOTARY PUBLIC