


WELL PLUGGING RECORD

15-445-60230-000

Give All Information Completely
Make Required Affidavit
Mail or Deliver Report to:
Conservation Division
State Corporation Commission
212 No. Market
Wichita, Kansas

Pawnee County, Sec. 26 Twp. 23 Rge. 16 (E) (W)

Location as "NE/CNW/SW" or footage from lines NE NE SW
Lease Owner Messman-Rinehart
Lease Name Ingles Well No. 1
Office Address 1432 Wichita Plaza Wichita, Ks.
Character of Well (completed as Oil, Gas or Dry Hole) gas well
Date well completed 10-8-67 19
Application for plugging filed 19
Application for plugging approved 19
Plugging commenced 11-30-67 19
Plugging completed 12-7-67 19
Reason for abandonment of well or producing formation _____

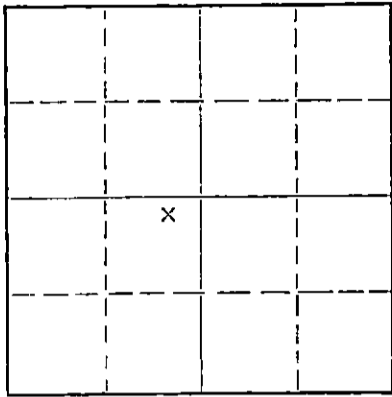

Locate well correctly on above Section Plat

If a producing well is abandoned, date of last production 19
Was permission obtained from the Conservation Division or its agents before plugging was commenced? yes

Name of Conservation Agent who supervised plugging of this well Leo Massey
Producing formation _____ Depth to top _____ Bottom _____ Total Depth of Well 4213 Feet
Show depth and thickness of all water, oil and gas formations.

OIL, GAS OR WATER RECORDS

CASING RECORD

FORMATION	CONTENT	FROM	TO	SIZE	PUT IN	PULLED OUT
				8 5/8	225'	none
				5 1/2	4195'	2150'

Describe in detail the manner in which the well was plugged, indicating where the mud fluid was placed and the method or methods used in introducing it into the hole. If cement or other plugs were used, state the character of same and depth placed, from _____ feet to _____ feet for each plug set.

Fill hole with sand from 4213' to 4170' and dump 5 sacks of cement

Globe pumped 25 sacks of Jell and 100 sacks of cement down 8 5/8" pipe

DEC 26 1967
12-26-67
CONSERVATION DIVISION
Wichita, Kansas

(If additional description is necessary, use BACK of this sheet)

Name of Plugging Contractor Flint Engineering and Const. Co.
Address 2375 W. Central El Dorado, Kansas

STATE OF Kansas, COUNTY OF Butler, ss.

(employee of owner) or (owner or operator) of the above-described well, being first duly sworn on oath, says: That I have knowledge of the facts, statements, and matters herein contained and the log of the above-described well as filed and that the same are true and correct. So help me God.

(Signature) Kenneth Smith

SUBSCRIBED AND SWORN TO before me this 19 day of December, 19 67

(Address) _____
James Davis
Notary Public.

