


WELL PLUGGING RECORD

Give All Information Completely  
Make Required Affidavit  
Mail or Deliver Report to:  
Conservation Division  
State Corporation Commission  
800 Bittling Building  
Wichita, Kansas

Rice County, Sec. 8 Twp. 21 Rge. 6 W (E) (W)

Location as "NE/CNW/SW" or footage from lines NE of SE/4  
Lease Owner Berry & Eells  
Lease Name Walston Well No. 2  
Office Address Box 206, Newton, Kansas  
Character of Well (completed as Oil, Gas or Dry Hole) oil  
Date well completed July 22, 1949 19  
Application for plugging filed Sept. 8, 1949 19  
Application for plugging approved Sept. 8, 1949 19  
Plugging commenced Sept. 10, 1949 19  
Plugging completed Sept. 15, 1949 19  
Reason for abandonment of well or producing formation Fluid decreased in well until it was unprofitable to produce  
If a producing well is abandoned, date of last production No actual production 19  
Was permission obtained from the Conservation Division or its agents before plugging was commenced? Yes

NORTH

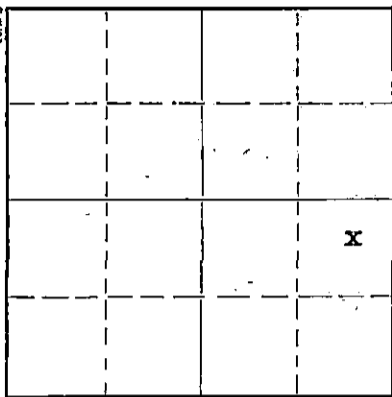

Locate well correctly on above Section Plat

Name of Conservation Agent who supervised plugging of this well R. Durkee  
Producing formation Mississippian chert Depth to top 3504 Bottom 3566 Total Depth of Well 3566 Feet  
Show depth and thickness of all water, oil and gas formations.

OIL, GAS OR WATER RECORDS

CASING RECORD

Formation	Content	From	To	Size	Put In	Pulled Out
Mississippian chert	water & oil	surface	3504	5 1/2	3504	2544'

Describe in detail the manner in which the well was plugged, indicating where the mud fluid was placed and the method or methods used in introducing it into the hole. If cement or other plugs were used, state the character of same and depth placed, from.....feet to.....feet for each plug set.

Rocked hole to 3500'. Run 6 sacks of cement.  
Mudded hole to 150'. Set Rock bridge & run 15 sacks of cement.  
Mudded hole to top. Run 5 sacks of cement.  
Well Completed.

RECEIVED  
Conservation Div.  
SEP 20 1949  
STATE CORPORATION COMMISSION  
KANSAS

9-20-49

(If additional description is necessary, use BACK of this sheet)

Correspondence regarding this well should be addressed to Berry & Eells  
Address Box 206 Newton, Kansas

STATE OF Kansas COUNTY OF Harvey ss.

Dwight N. Eells, operator (employee of owner) or (owner or operator) of the above-described well, being first duly sworn on oath, says: That I have knowledge of the facts, statements, and matters herein contained and the log of the above-described well as filed and that the same are true and correct. So help me God.

(Signature) Dwight N. Eells  
Box 206, Newton, Kan  
(Address)

SUBSCRIBED AND SWORN to before me this 19th day of September 1949

My Commission Expires Sept. 27, 1951

Notary Public.

PLUGGING  
FILE SEC 2 T 21 Row  
BOOK PAGE 13 LINE 5

Copy of log as furnished by the B. & R. Drilling, Inc.

Walsten # 2, Sec. 8, Twp 21 Rge 6W  
Rice County, Kansas

Total depth: 3515

Comm: 6/17/49

Compl 6/30/49

Casing

Cement

8 5/8" Set @ 154'

120 Sacks

5 1/2 Set @ 3299' \*

65 Secks

Formation	Depth
Sand	55
Red Bed	70
Shale & Red Bed	105
Shale, Shells & Red Bed	154
Shale, Shells & Red Bed	310
Shale & Shells	405
Shale, Sand & Red Bed	493
Anhydrite	530
Shale & Shells, Red Bed	565
Shale & Red Bed	710
Shale	850
Salt	1025
Salt & Shale	1155
Shale & Shells & Red Rock	1235
Shale & Shells	1325
Lime & Shale	1465
Lime & shale	1585
Lime & shale	2680
Lime	3270
Lime & Shale	3492
Cherty Congl.	3511
Chat	3515

Above from B. & R. Drilling Inc.

\* error pipe was set at 3508 from Rotary bushing.

Well drilled to 3566 in Chat, plugged back to 3528 with  
Calseal. Shot with 20 qts nitro. Swabbed at rate of 4 bbls per hr  
75% water. Put on pump fluid dropped to 20 bbls per day 75% water.

