


STATE OF KANSAS
STATE CORPORATION COMMISSION

Form CP-4

Give All Information Completely
Make Required Affidavit
Mail or Deliver Report to:
Conservation Division
State Corporation Commission
212 No. Market
Wichita, Kansas 67202

WELL PLUGGING RECORD

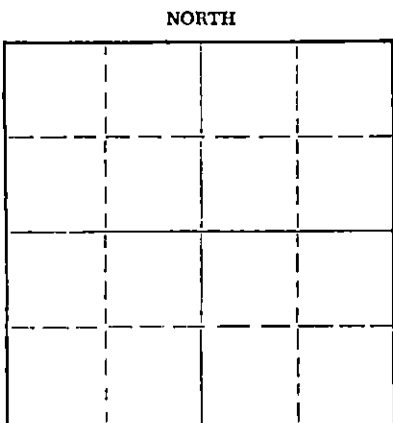

Locate well correctly on above
Section Plat

Rice County. Sec. 8 Twp. 21 Rge. 6 W (E) (W)
Location as "NE/CNW/SW" or footage from lines C NE NW NE
Lease Owner Pat Simmons
Lease Name Walstein Estate Well No. I
Office Address 5252 North Broadway, Wichita, Kansas
Character of Well (completed as Oil, Gas or Dry Hole) oil
Date well completed 6-29 19 53
Application for plugging filed 12-31 19 69
Application for plugging approved I-2 19 70
Plugging commenced I-27 19 70
Plugging completed 2-27 19 70
Reason for abandonment of well or producing formation

If a producing well is abandoned, date of last production 19
Was permission obtained from the Conservation Division or its agents before plugging was commenced? Yes

Name of Conservation Agent who supervised plugging of this well Gilbert Toman
Producing formation Depth to top Bottom Total Depth of Well 3507' Feet
Show depth and thickness of all water, oil and gas formations.

OIL, GAS OR WATER RECORDS

CASING RECORD

FORMATION	CONTENT	FROM	TO	SIZE	PUT IN	PULLED OUT
				5 1/2"		485'

Describe in detail the manner in which the well was plugged, indicating where the mud fluid was placed and the method or methods used in introducing it into the hole. If cement or other plugs were used, state the character of same and depth placed, from feet to feet for each plug set.

Plugged off bottom of hole with rock. Rock from 3507' to 3470'. Dumped 5 sx of cement. Pumped 20 sx of ~~mud~~ mud and squeezed with 75 sx of cement.

RECEIVED
STATE CORPORATION COMMISSION
AUG 14 1970
CONSERVATION DIVISION
Wichita, Kansas

8-14-70

(If additional description is necessary, use BACK of this sheet)

Name of Plugging Contractor Art Lamb Casing Pulling Co.
Address 2809 King St. Hutchinson, Kansas 67501

STATE OF Kansas, COUNTY OF Seneca, ss.
Art Lamb (employee of owner) or (owner or operator) of the above-described well, being first duly sworn on oath, says: That I have knowledge of the facts, statements, and matters herein contained and the log of the above-described well as filed and that the same are true and correct. So help me God.

(Signature) [Signature]
2809 King St. Hutchinson, K (Address)

SUBSCRIBED AND SWORN to before me this 13th day of August, 19 70

My commission expires Jan 5, 1974
[Signature] Notary Public.


WELL LOG BUREAU--KANSAS GEOLOGICAL SOCIETY
503 East Murdock, Wichita, Kansas

Company. H. C. BENNETT
Farm. Walsten Estate No. 1

SEC. 8 T. 21 R. 6W
C NE NW NE

Total Depth. 3507
Comm. 6-22-53 Comp. 6-29-53
Shot or Treater. Sand-Fracked
Contractor. Salina Drilling Co.
Issued. 11-12-55

County Rice
KANSAS

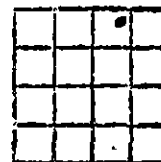

CASING:
5 1/2 @ 3489'

Elevation. 1674

Production. 23 BO, 15 BWPD

Figures indicate Bottom of Formations.

cellar - base & RT	8
sand	45
red bed	70
red bed & shale	400
shale	950
shale & shells	1005
lime	1055
lime & shale	1280
shale & sand	1480
lime & shale	2000
shale & lime streaks	2210
shale & lime	2380
lime	2845
shale & lime	2935
lime	3230
lime & shale	3295
shale	3395
shale & lime	3465
shale	3477
conglomerate	3488
Mississippi lime RTD	3491
Mississippi lime	3507
Total Depth	

TOPS:	
Basal sand	3436
Conglomerate	3477
Mississippi	3486

Drilled with Cable Tools to 3494' for a slight showing of oil, drilled to a Total Depth of 3507'. Sand Fracked and completed for 25 bbls per day.

RECEIVED
STATE CORPORATION COMMISSION
JAN 5 1969
CONSERVATION DIVISION
Wichita, Kansas