

RECEIVED
STATE CORPORATION COMMISSION

OCT 11 1972


10-12-72

STATE OF KANSAS
STATE CORPORATION COMMISSION

Give All Information Completely
Make Required Affidavit
Mail or Deliver Report to:
Conservation Division
State Corporation Commission
212 No. Market
Wichita, Kansas 67202

CONSERVATION DIVISION
Wichita, Kansas
WELL PLUGGING RECORD

NORTH

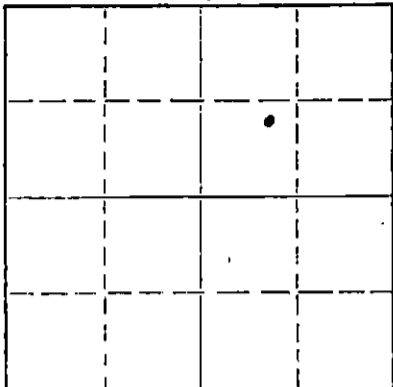

Locate well correctly on above
Section Plat

Rice County, Sec. 8 Twp. 21 Rge. 6 (E) 6 (W)
Location as "NE/CNW/SE/SW" or footage from lines NE SW NE
Lease Owner F. G. Holl
Lease Name Walsten "B" Well No. 2
Office Address 6427 E. Kellogg, Wichita, Kansas
Character of Well (completed as Oil, Gas or Dry Hole) oil
Date well completed 1972
Application for plugging filed Sept. 25 1972
Application for plugging approved 1972
Plugging commenced Sept. 25 1972
Plugging completed Oct. 5 1972
Reason for abandonment of well or producing formation depleted

If a producing well is abandoned, date of last production 1972
Was permission obtained from the Conservation Division or its agents before plugging was commenced? yes

Name of Conservation Agent who supervised plugging of this well Gilbert Toman
Producing formation _____ Depth to top _____ Bottom _____ Total Depth of Well 3527 Feet
Show depth and thickness of all water, oil and gas formations.

OIL, GAS OR WATER RECORDS

CASING RECORD

FORMATION	CONTENT	FROM	TO	SIZE	PUT IN	PULLED OUT
		0	202'	8 5/8"	202	none
		0	3526'	4 1/2"	3526	1260.43

Describe in detail the manner in which the well was plugged, indicating where the mud fluid was placed and the method or methods used in introducing it into the hole. If cement or other plugs were used, state the character of same and depth placed, from _____ feet to _____ feet for each plug set.

Sanded back to 3480' and dumped 4 sacks of cement.
Set 15' rock bridge at 200'. Plugged well with 3 yards of ready mix cement.

(If additional description is necessary, use BACK of this sheet)
Name of Plugging Contractor PIPE PULLERS, INC.
Address Box 486, Ellinwood, Kansas

STATE OF KANSAS, COUNTY OF BARTON, ss.
Evelyn Roth (employee of owner) or (owner or operator) of the above-described well, being first duly sworn on oath, says: That I have knowledge of the facts, statements, and matters herein contained and the log of the above-described well as filed and that the same are true and correct. So help me God.

(Signature) Evelyn Roth
Ellinwood, Kansas
(Address)

SUBSCRIBED AND SWORN to before me this 10th day of October, 1972

My commission expires Feb. 10, 1975
George A. Meyer Notary Public

STERLING DRILLING COMPANY
P. O. Box 129
Sterling, Kansas 67579

WELL LOG ----- WALSTEN "B" #2
Located: NE SW NE, Section 8-21S-6W, Rice County, Kansas

OWNER: F. G. Holl
ROTARY DRILLING CONTRACTOR: Sterling Drilling Company

COMMENCED: July 8, 1970
COMPLETED: July 14, 1970

TOTAL DEPTH: 3527'

<u>LOG</u>	
0 - 45	Sand
45 - 207	Sand and Shale
207 - 1015	Shale, Salt, Lime
1015 - 2564	Shale and Lime
2564 - 2705	Lime
2705 - 2960	Lime and Shale
2960 - 3180	Lime
3180 - 3280	Lime and Shale
3280 - 3450	Lime
3450 - 3502	Lime and Shale
3502 - 3527	Conglomerate - Mississippi

CASING RECORD

Ran 5 joints 8 5/8" 20# new seamless casing, 190.01 pipe set at 202.00 K.B. Cemented with 180 sacks Pozmix with 3% HA5. Plug down 8:45 PM, 7-8-70.

RECEIVED
STATE CORPORATION COMMISSION
SEP 26 1970
CONSERVATION DIVISION
Wichita, Kansas

Ran 111 joints 4 1/2" O.D. Casing, 3551' pipe, cemented at 3526' K.B. with 75 sacks Pozmix, 1/2# floseal per sack. Plug down @ 12:30 PM, 7-14-70.