

STATE OF KANSAS  
 STATE CORPORATION COMMISSION


Give All Information Completely  
 Make Required Affidavit  
 Mail or Deliver Report to:  
 Conservation Division  
 State Corporation Commission  
 800 Bitting Building  
 Wichita, Kansas

OR

**FORMATION PLUGGING RECORD**

Strike out upper line  
 when reporting plug-  
 ging off formations.

Barton County, Sec. 22 Twp. 16S Rge. 12 ~~XX~~ W. (W)  
 Location as "NE $\frac{1}{4}$ NW $\frac{1}{4}$ SW $\frac{1}{4}$ " or footage from lines C. N. L. N. E. S. W.  
 Lease Owner: The Vickers Petroleum Co., Inc.  
 Lease Name: Dolechek Well No. 1  
 Office Address: 201 W-K-H Bldg., Wichita, Kansas  
 Character of Well (completed as Oil, Gas or Dry Hole): oil  
 Date well completed: Sept. 5 19 41  
 Application for plugging filed: December 20 19 48  
 Application for plugging approved: December 20 19 48  
 Plugging commenced: December 20 19 48  
 Plugging completed: January 5 19 49  
 Reason for abandonment of well or producing formation: Ceased to produce oil  
 If a producing well is abandoned, date of last production: October 6 19 48  
 Was permission obtained from the Conservation Division or its agents before plugging was com-  
 menced? yes

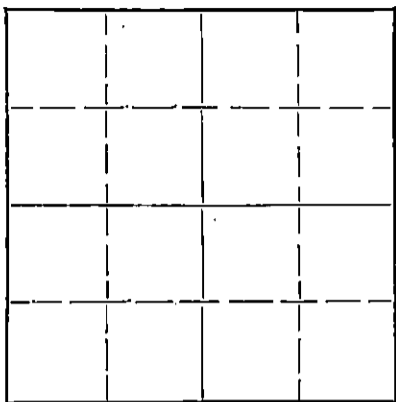

Locate well correctly on above  
 Section Plat

Name of Conservation Agent who supervised plugging of this well: C. D. Stough, Great Bend, Kansas  
 Producing formation: Arb. Lime Depth to top: 3379 Bottom: 3379 Total Depth of Well: 3379 Feet  
 Show depth and thickness of all water, oil and gas formations.

**OIL, GAS OR WATER RECORDS**

**CASING RECORD**

Formation	Content	From	To	Size	Put In	Pulled Out
				10-3/4"	271'	None
				5-1/2"	3272'	1756'

Describe in detail the manner in which the well was plugged, indicating where the mud fluid was placed and the method or methods used in introducing it into the hole. If cement or other plugs were used, state the character of same and depth placed, from \_\_\_\_\_ feet to \_\_\_\_\_ feet for each plug set.

Dump 5 sx on bottom 3379 to 3360. Mudded hole to 271'. Set rock Bridge.  
 Dump 20 sx cement @ 250'. Fill w/mud to 30'. Dump 10 sx cement. Fill to base of cellar.

RECEIVED  
 JAN 21 1949  
 CONSERVATION DIVISION  
 KANSAS  
 1-21-49

(If additional description is necessary, use BACK of this sheet)  
 Correspondence regarding this well should be addressed to: The Vickers Petroleum Co., Inc.  
 Address: 201 W-K-H Bldg., Wichita, Kansas

STATE OF Kansas, COUNTY OF Sedgwick, ss.  
John M. Little (employee of owner) or (owner or operator) of the above-described well,  
 being first duly sworn on oath, says: That I have knowledge of the facts, statements, and matters herein contained and the log of the above-described well as filed and that the same are true and correct. So help me God.

(Signature) John M. Little  
 201 W-K-H Building, Wichita, Kansas  
 (Address)

SUBSCRIBED AND SWORN to before me this 21st day of January, 19 49  
Allen J. Denton  
 Notary Public.

My commission expires August 13, 1949  
 22-2625 2-48-15M

**PLUGGING**  
 FILE SEC 22 16 R 12 W  
 BOOK PAGE 78 LINE 15

15-009-19369-00-00

THE VICKERS PETROLEUM COMPANY

Dolechek Lease: Well No. 1

Commenced: July 30, 1941

CNL NE SW 22-16-12W

Completed: Sept. 5, 1941

Barton County, Kansas

Contractor: Jayhawk Oil Company

Casing: 10-3/4" 271' cemented with 175 sacks  
5-1/2" O.D. 3372' cemented with 150 sacks

0 to 275	Surface
500	Shale & Shells
815	Shale, shells & red bed
845	Anhydrite
1025	Shale & shells
1310	Shale & red bed
1375	Salt
1495	Salt & shale
1575	Shale & shells
1910	Shale, shells & red bed
1970	Lime
2550	Shale & shells
2700	Shale & Lime
2710	Shale & lime
2940	Lime
3035	Broken lime
3095	Shale & lime
3372	Lime
3373	Sand (Gorham)
3379	Lime (Arbuckle)

Total Depth 3379


RUST

Drill plug and cleaned out to total depth

Filled 900' with oil in 2 hours.

No acid.

Physical potential 282 barrels oil per day and no water.

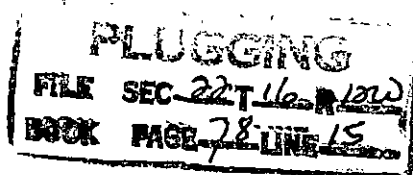

RECEIVED  
COMMISSION DIV.  
JAN 21 1949  
STATE CORPORATION  
COMMISSION  
KANSAS  
1-21-49