


NORTH

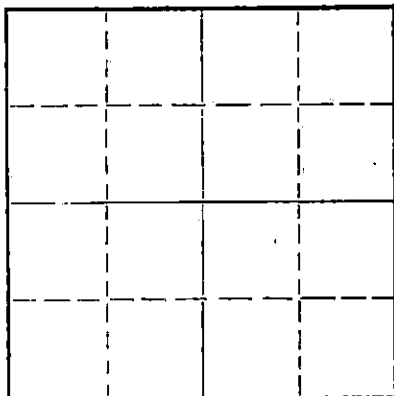

Locate well correctly on above Section Plat

Barton County, Sec. 22 Twp. 16 Rge. (E) 12 (W)
 Location as "NE/CNW/SW" or footage from lines CE/2 NE SE
 Lease Owner Great Bend Pipe & Supply
 Lease Name Reiman "B" Well No. 1
 Office Address _____
 Character of Well (completed as Oil, Gas or Dry Hole) Oil
 Date well completed _____ 19____
 Application for plugging filed _____ 19____
 Application for plugging approved _____ 19____
 Plugging commenced 1-11 19 62
 Plugging completed 1-19 19 62
 Reason for abandonment of well or producing formation _____

If a producing well is abandoned, date of last production _____ 19____
 Was permission obtained from the Conservation Division or its agents before plugging was commenced? yes

Name of Conservation Agent who supervised plugging of this well Donald Truan
 Producing formation _____ Depth to top _____ Bottom _____ Total Depth of Well 3391 Feet
 Show depth and thickness of all water, oil and gas formations.

OIL, GAS OR WATER RECORDS

CASING RECORD

FORMATION	CONTENT	FROM	TO	SIZE	PUT IN	PULLED OUT
				8 5/8"	281'	none
				5 1/2"	3366'	2760'

Describe in detail the manner in which the well was plugged, indicating where the mud fluid was placed and the method or methods used in introducing it into the hole. If cement or other plugs were used, state the character of same and depth placed, from _____ feet to _____ feet for each plug set.

Sanded hole from 3391' to 3350'-
dumped 4 sks cement-pulled casing-
mudded hole to 310'-set 10' rock
bridge-dumped 40 sks cement-mudded
hole to 40'-set 10' rock bridge-
dumped 10 sks cement.

RECEIVED
 STATE CORPORATION COMMISSION

JAN 31 1962

CONSERVATION DIVISION
 Wichita, Kansas

1-31-62

(If additional description is necessary, use BACK of this sheet)
 Name of Plugging Contractor R & D Casing Pulling Co. License #236
 Address Box 572, Hutchinson, Kansas

STATE OF Kansas, COUNTY OF Barton, ss.
~~XXXXXXXXXXXXXXXXXXXX~~ Nathan Meltzer (Employee of owner) or (~~owner~~ operator) of the above-described well, being first duly sworn on oath, says: That I have knowledge of the facts, statements, and matters herein contained and the log of the above-described well as filed and that the same are true and correct. So help me God.

(Signature) Nathan Meltzer
Drawer "B" - Great Bend, Kansas.
 (Address)

SUBSCRIBED AND SWORN to before me this 30 day of January, 19 62

My commission expires March 30, 1965
Anne Meltzer Notary Public.

15-009-03335-00-00

WELL LOG BUREAU KANSAS GEOLOGICAL SOCIETY
412 Union National Bk Bldg. Wichita, Kansas

Company - C. U. BAY
Farm - Riemann "B"

No. 1

SEC. 22 T. 16 R. 12E
CB₂ NE SE

Total Depth 3373'

Comm. 2-24-48

Comp. 5-1-48


County. Barton

KANSAS

Shot or Treated.

Contractor. Gabbert & Lindas Drlg. Co., Inc.

Issued. 5-29-48

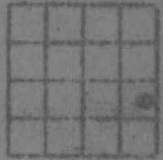

CASING:

8-5/8" 282' Cem. W/ 150 Sx. (RB)

5" (RB) 3369' Cem. W/ 75 Sx.

Elevation. _____

Production. Pot. 69.08 BO/8 hr.
no water.

Figures Indicate Bottom of Formations.

sand & shale	281
shale & sand	550
red bed & shale	620
shale - shells	820
anhydrite	835
red bed & shale	1125
shale & shells	1195
shale & salt	1330
shale	1420
shale & shells	1675
shale & lime	1915
lime	2035
lime brkn	2125
lime brkn	2235
shale & lime	2455
lime brkn	2708
lime	2857
shale & lime	2970
lime	3014
lime & shale	3100
lime	3371
sand	3373

Total Depth R.B.

Tops:

Br. lime D.F.	3087
Kansas City D.F.	3101
Gocham sand D.F.	3364

Slight show oil 3114-18
very small show oil 3189-93
good por. & good show oil 3368-70

D.P. - Cleaned out to RTD - 3373
Very small show oil.
D.D. - 3376, no increase
B pts. 3376-70

RECEIVED
STATE GEOLOGICAL SURVEY

JAN 10 1948

CONSERVATION DIVISION
Wichita, Kansas