


STATE OF KANSAS  
STATE CORPORATION COMMISSION

WELL PLUGGING RECORD

Give All Information Completely.  
Make Required Affidavit  
Mail or Deliver Report to  
Conservation Division  
State Corporation Comm.  
245 North Water  
Wichita, KS 67202

Barton County. Sec. 22 Twp. 16 Rge. 12 N/W  
Location as "NE/CNW $\frac{1}{4}$ /SW $\frac{1}{4}$ " or footage from lines  
C NW NE SE

Lease Owner Tenneco Oil Company  
Lease Name Riemann B Well No. 2  
Office Address 139 Ciudad Bldg., Oklahoma City, Okla.  
Character of Well (Completed as Oil, Gas or Dry Hole) 73112  
oil

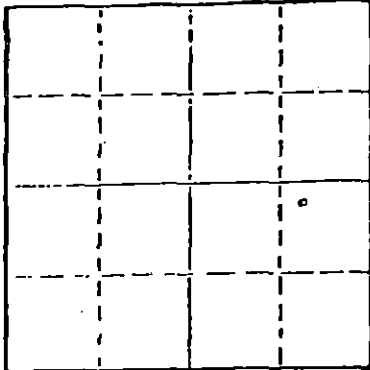

Locate well correctly on above  
Section Plat

Date Well completed 19  
Application for plugging filed 19  
Application for plugging approved 19  
Plugging commenced March 8 1978  
Plugging completed March 31 1978  
Reason for abandonment of well or producing formation  
depleted

If a producing well is abandoned, date of last production  
19

Was permission obtained from the Conservation Division or  
its agents before plugging was commenced? yes

Name of Conservation Agent who supervised plugging of this well Duane Rankin  
Producing formation \_\_\_\_\_ Depth to top \_\_\_\_\_ Bottom \_\_\_\_\_ Total Depth of Well 3375'  
Show depth and thickness of all water, oil and gas formations.

OIL, GAS OR WATER RECORDS

CASING RECORD

FORMATION	CONTENT	FROM	TO	SIZE	PUT IN	PULLED OUT
		0	274'	8 5/8"	274'	none
			3369'	5 1/2"	3369'	519.48

Describe in detail the manner in which the well was plugged, indicating where the mud fluid  
was placed and the method or methods used in introducing it into the hold. If cement or other  
plugs were used, state the character of same and depth placed, from \_\_\_\_\_ feet to  
\_\_\_\_\_ feet for each plug set.

Sanded back to 3050' and dumped 5 sacks of cement.

Halliburton Services plugged well pumping in 3 sacks of hulls, 10 sacks of gel  
and 100 sacks of cement.

RECEIVED  
APR 07 1978  
4-7-78  
CONSERVATION DIVISION

(If additional description is necessary, use BACK of this sheet)

Name of Plugging Contractor PIPE PULLERS, INC.  
Box 128, Ellinwood, Kansas 67526

STATE OF KANSAS COUNTY OF BARTON, ss.  
Evelyn Roth (employee of owner) or (owner-or-operator)  
of the above-described well, being first duly sworn on oath, says: That I have knowledge of  
the facts, statements, and matters herein contained and the log of the above-described well  
as filed and that the same are true and correct. So help me God.

(Signature) Evelyn Roth  
Ellinwood, Kansas  
(Address)

SUBSCRIBED AND SWORN TO before me this 6th day of April, 1978

My commission expires \_\_\_\_\_

JENNY KASSELMAN  
NOTARY PUBLIC  
BARTON COUNTY, KANSAS  
MY COMM. EXP. JULY 16, 1978

Jenny Kasselmann  
Notary Public.

WELL LOG BUREAU - KANSAS GEOLOGICAL SOCIETY

412 Union National Bldg., Wichita, Kansas


15-009-03336-00-00

Company - BAY PETROLEUM CO.  
 Farm - Reimann "B" No. 2

SEC. 22 T. 16 R. 12W  
 NW 1/4 SE

Total Depth. 3375' D.F.  
 Comm. 7-5-48 Comp. 9-16-48  
 Shot or Treated. Acidized w/500 gals.  
 Contractor. Gabbert & Lindas Drlg. Co., Inc.  
 Issued. 10-9-48

County. Barton  
 KANSAS

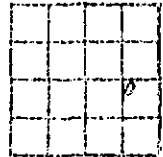

Elevation. \_\_\_\_\_

Production. Pot. 322 Bbls.

Figures indicate Bottom of Formations.

surface clay	30
lime & shells	40
gravel	135
shale	280
shale & sand	370
shale & shells	820
anhydrite & shale	865
shale & shells	1240
salt & shale	1510
lime brkn	1970
lime & shale	2055
lime	2215
shale & shells	2505
lime & shale	2630
shale & shells	2784
lime	3000
lime & shale	3060
shale & shells	3094
lime	3355
lime & shale RTD	3372
arbutle lime	3375 D.F.
Total Depth	

Tops, D.F.:	
Anhydrite	820
Brn. Lansing	3092
Lansing K. C.	3107
Arbutle	3368

Testing Information:  
 D: & D.D. 1' to 3373'  
 small show oil - D.D. 2'  
 to 3375' - bail 3 BOPH  
 500 acid - Swab 7 BOPH/  
 7 hrs. fill up 1360'/6'  
 hrs. no water.

RECEIVED  
 CONSERVATION COMMISSION  
 JAN 13 1978  
 CONSERVATION DIVISION  
 Wichita, Kansas

*Chase file*