


Give All Information Completely
Make Required Affidavit
Mail or Deliver Report to:
Conservation Division
State Corporation Commission
212 North Market, Insurance Bldg.
Wichita, Kansas

WELL PLUGGING RECORD

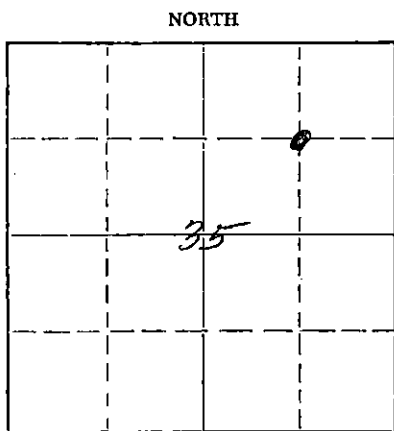

Locate well correctly on above
Section Plat

Hamilton County. Sec. 35 Twp. 21S Rge. 42 (X) W (W)
Location as "NE/CNW/SW" or footage from lines C NE/4
Lease Owner Socony Mobil Oil Co., Inc.
Lease Name Cauthorn Unit Well No. 1
Office Address 300 N. Broadway, Wichita, Kansas 67202
Character of Well (completed as Oil, Gas or Dry Hole) Dry Hole
Date well completed 19 63
Application for plugging filed 7-26 19 63
Application for plugging approved (Plugged upon completion as dry hole)
Plugging commenced 7-24 19 63
Plugging completed 7-24 19 63
Reason for abandonment of well or producing formation Drilled Dry

If a producing well is abandoned, date of last production --- 19
Was permission obtained from the Conservation Division or its agents before plugging was commenced? YES

Name of Conservation Agent who supervised plugging of this well Hugh Scott
Producing formation NONE Depth to top Bottom Total Depth of Well 2800 Feet
Show depth and thickness of all water, oil and gas formations.

OIL, GAS OR WATER RECORDS

CASING RECORD

FORMATION	CONTENT	FROM	TO	SIZE	PUT IN	PULLED OUT
NONE				8-5/8"	202'	NONE
				4-1/2"	2799'	NONE

Describe in detail the manner in which the well was plugged, indicating where the mud fluid was placed and the method or methods used in introducing it into the hole. If cement or other plugs were used, state the character of same and depth placed, from feet to feet for each plug set.

Dumped 2 yards ready mix concrete 2775' to 2375'. Filled w/mud 2375-500'. Set home made plug @ 500' w/Halliburton Line. Left wire line in hole. Dumped 10' of gravel on plug
Dumped 3 yds. ready mix concrete from 490' to surface. Cut off 4-1/2 csg. & 8-5/8" csg. 3 feet below surface and capped.

RECEIVED
STATE CORPORATION COMMISSION

JUL 31 1963

CONSERVATION DIVISION
Wichita, Kansas

(If additional description is necessary, use BACK of this sheet)

Name of Plugging Contractor Tom's Well Service
Address Box 733, Garden City, Kansas

STATE OF Kansas, COUNTY OF Sedgwick, ss.
L. L. Davis

(employee of owner) or (owner or operator) of the above-described well, being first duly sworn on oath, says: That I have knowledge of the facts, statements, and matters herein contained and the log of the above-described well as filed and that the same are true and correct. So help me God.

(Signature)

300 N. Broadway, Wichita, Kansas

(Address)

SUBSCRIBED AND SWORN TO before me this 29th day of July, 19 63

My commission expires 4-4-66

Notary Public.

LEASE: C. G. CAUTHORN UNIT #1
 OWNER: MOBIL OIL COMPANY
 CONTRACTOR: EARL F. WAKEFIELD
 COMMENCED: 7-5-63
 COMPLETED: 7-10-63

LOCATION: C NE
 SECTION 35-21S-42W
 HAMILTON COUNTY, KANSAS
 CASING: 8 5/8" Set at 200'
 4 1/2" Set at 2799'

Surface Soil	25
Sand	90
Yellow Clay	110
Blue Shale	204
Blue Shale, Shells	590
Shale Shells & Sand	1100
Shale and Shells - Red Bed	1505
Shale - Red Bed	1665
Lime - Shale	1705
Salt - Shale - Gyp	1785
Red Bed - Salt	1925
Salt and Shells	2055
Shale and Shells	2328
Anhydrite - Shale	2405
Lime and Shale	2800
F.D.	2800

RECEIVED
 STATE CORPORATION COMMISSION

JUL 31 1963

CONSERVATION DIVISION
 Wichita, Kansas

STATE OF KANSAS)
) SS
 COUNTY OF SEDGWICK)

I hereby certify that the above is a true and correct copy of the log on the C. G. CAUTHORN UNIT WELL No. 1, located C NE Section 35, Township 21 South, Range 42 West, Hamilton County, Kansas.

EARL F. WAKEFIELD

By Frank J. Barker

Subscribed and sworn before me this 19th day of July, 1963.

My commission expires:
January 25, 1965

Wanda W. Riley
 WANDA W. RILEY

NOTARY