


Give All Information Completely
Make Required Affidavit
Mail or Deliver Report to:
Conservation Division
State Corporation Commission
221 No. Broadway
Wichita, Kansas

WELL PLUGGING RECORD

Hamilton County, Sec. 25 Twp. 21S Rge. XE 42 (W)

Location as "NE/CNW/SW" or footage from lines Ctr. NW - SE
Lease Owner Champlin Oil & Refining Co.
Lease Name Paul R. Staten Well No. 1
Office Address P. O. Box 308, Ellinwood, Kansas
Character of Well (completed as Oil, Gas or Dry Hole) Dry Hole
Date well completed June 14 1963
Application for plugging filed June 17 1963
Application for plugging approved June 18 1963
Plugging commenced June 25 1963
Plugging completed June 27 1963
Reason for abandonment of well or producing formation _____

NORTH

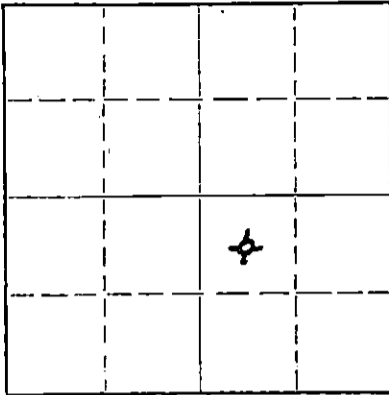

Locate well correctly on above
Section Plat

If a producing well is abandoned, date of last production _____ 19____
Was permission obtained from the Conservation Division or its agents before plugging was commenced? Yes

Name of Conservation Agent who supervised plugging of this well Hugh E. Scott
Producing formation _____ Depth to top _____ Bottom _____ Total Depth of Well 2789 Feet
Show depth and thickness of all water, oil and gas formations.

OIL, GAS OR WATER RECORDS

CASING RECORD

FORMATION	CONTENT	FROM	TO	SIZE	PUT IN	PULLED OUT
				8 5/8" OD	202'	None
				4 1/2" OD	2783'	1234'

Describe in detail the manner in which the well was plugged, indicating where the mud fluid was placed and the method or methods used in introducing it into the hole. If cement or other plugs were used, state the character of same and depth placed, from _____ feet to _____ feet for each plug set.

Filled hole with sand from 2789' T.D. to 2750' and dumped 4 sacks of cement on top of sand. Filled hole with mud to 300' and built 15' rock bridge and 20 sacks of cement then filled hole with mud to 30' and filled hole to bottom of cellar using 10 sacks of cement.

RECEIVED
STATE CORPORATION COMMISSION

JUL 10 1963

CONSERVATION DIVISION
Wichita, Kansas

(If additional description is necessary, use BACK of this sheet)

Name of Plugging Contractor Forbes Casing Pulling, Inc.
Address P. O. Box 221, Great Bend, Kansas.

STATE OF Kansas, COUNTY OF Barton, ss.
J. W. Meyers (employee of owner) or ~~(owner or operator)~~ of the above-described well, being first duly sworn on oath, says: That I have knowledge of the facts, statements, and matters herein contained and the log of the above-described well as filed and that the same are true and correct. So help me God.

(Signature)

P. O. Box 308, Ellinwood, Kansas
(Address)

Subscribed and sworn to before me this 9th day of July 1963

N. Kenneth Stone
Notary Public.


My commission expires 5-22-66.

STATE OF KANSAS
STATE CORPORATION COMMISSION

Form CP-4

Give All Information Completely
Make Required Affidavit
Mail or Deliver Report to:
Conservation Division
State Corporation Commission
211 No. Broadway
Wichita, Kansas

WELL PLUGGING RECORD

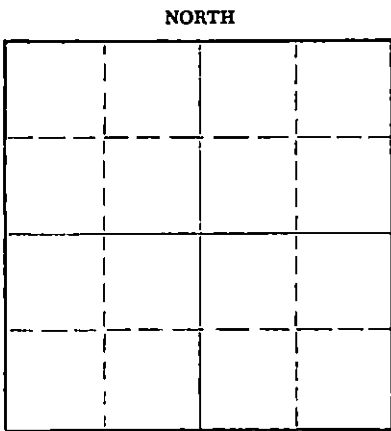

Hamilton County. Sec. 25 Twp. 21S Rge. 12W (E) (W)
Location as "NE/CNW/SW" or footage from lines C/ NW / SE
Lease Owner Champlin Refining Company
Lease Name Paul R. Staten Well No. 1
Office Address P. O. Box 308 Ellinwood, Kansas
Character of Well (completed as Oil, Gas or Dry Hole) Oil Gas
Date well completed _____ 19____
Application for plugging filed _____ 19____
Application for plugging approved _____ 19____
Plugging commenced June 25, 1963 _____ 19____
Plugging completed June 27, 1963 _____ 19____
Reason for abandonment of well or producing formation Dry

If a producing well is abandoned, date of last production _____ 19____
Was permission obtained from the Conservation Division or its agents before plugging was commenced? Yes

Name of Conservation Agent who supervised plugging of this well Hugh E. Scott
Producing formation _____ Depth to top _____ Bottom _____ Total Depth of Well 2768 Feet
Show depth and thickness of all water, oil and gas formations.

OIL, GAS OR WATER RECORDS

CASING RECORD

FORMATION	CONTENT	FROM	TO	SIZE	PUT IN	PULLED OUT
				8 5/8	202	None
				1 1/2	None	1246

Describe in detail the manner in which the well was plugged, indicating where the mud fluid was placed and the method or methods used in introducing it into the hole. If cement or other plugs were used, state the character of same and depth placed, from _____ feet to _____ feet for each plug set.

Moved in. Rigged up. Blowing well.
Pumping salt water to kill well. Plugging well. Sanded to 2750' and
1 1/2 sacks of cement. Setting up jacks and working pipe. Shot pipe at
2250'. Working pipe. Shot at 2100' and 100' to 123 1/2'.
every
Pulling pipe. Plugged well at 300'. Build 15' rock bridge and 20
sacks of cement. Filled hole to 30'. Mixed 10 sacks for cap on well.

RECEIVED
STATE CORPORATION COMMISSION

JUL 8 1963

CONSERVATION DIVISION
Wichita, Kansas

(If additional description is necessary, use BACK of this sheet)

Name of Plugging Contractor Forbes Casing Pulling, Inc.
Address Box 221 Great Bend, Kansas

STATE OF Kansas, COUNTY OF Barton, ss.
J. O. Forbes (employee of owner) or (owner or operator) of the above-described well, being first duly sworn on oath, says: That I have knowledge of the facts, statements, and matters herein contained and the log of the above-described well as filed and that the same are true and correct. So help me God.

(Signature) J O Forbes
Box 221 Great Bend, Kansas
(Address)

SUBSCRIBED AND SWORN TO before me this 5 day of July, 19 63

My commission expires May 27, 1964

Notary Public.

INVOICED

DATE 7/8/63

INV. NO. 7361-U

LEASE: PAUL R. STATEN UNIT #1 LOCATION: NW SE
 OPERATOR: CHAMPLIN OIL & REFINING SECTION 25-21S-42W
 CONTRACTOR: EARL F. WAKEFIELD HAMILTON COUNTY, KANSAS
 COMMENCE: 5-27-63 CASING: 8 5/8" Set at
 COMPLETE: 5-31-63 4 1/2" Set at

Surface	203
Shale	255
Gyp	360
Blue Shale and Shells	1030
Lime and Shale	1095
Shale and Gyp	1670
Red Bed and Salt	1985
Red Bed - Shells	2025
Lime and Shale	2130
Shale	2318
Lime and Anhydrite	2370
Lime and Shale	2789
T.L.	2789

RECEIVED
 STATE CORPORATION COMMISSION

JUL 10 1963

CONSERVATION DIVISION
 Wichita, Kansas

STATE OF KANSAS)
)
 COUNTY OF SEDGWICK) SS

I hereby certify that the above is a true and correct copy of the log on the PAUL R. STATEN UNIT #1 well, located NW SE SECTION 25-21S-42W, Hamilton County, Kansas.

EARL F. WAKEFIELD

By _____

Subscribed and sworn to before me this 10th day of June, 1963.

Notary Public for Kansas:
 Wanda W. Riley, 1963

Wanda W. Riley
 WANDA W. RILEY (NOTARY)



JOHN ANDERSON, Jr. Governor
 RICHARD C. BYRD Chairman
 ALVIN F. GRAUERHOLZ Commissioner
 HARRY G. WILES Commissioner
 RAYMOND B. HARVEY Secretary
 CHARLES C. McCARTER Gen. Counsel

State Corporation Commission

CONSERVATION DIVISION

(Oil, Gas and Water)
 500 Insurance Bldg. 212 N. Market
 WICHITA, KANSAS

RECEIVED
 STATE CORPORATION COMMISSION

July 23, 1963

JUL 29 1963

CONSERVATION DIVISION
 Wichita, Kansas

Re: Well No. Champlin Refining Co.
 1
 Lease Paul R. Staten
 Description C NW SE 25-21-42W
 County Hamilton
 DATE PLUGGED: June 27, 1963

Hugh Scott
 Sublette, Kansas

Dear Sir:

We received on July 8, 1963 the well plugging record on the above captioned well, but have not received your agents report.

Please mail this report immediately so that we can invoice the operator for the fee.

Very truly yours,

J.P. Roberts
 J. P. ROBERTS
 Assistant Petroleum Conservation
 Director

JPR:bh

This well was plugged while I was on vacation. The information I am sending in was obtained from the Farber Casing Pulling, Great Bend, Kansas.

*Yours,
 Hugh Scott*