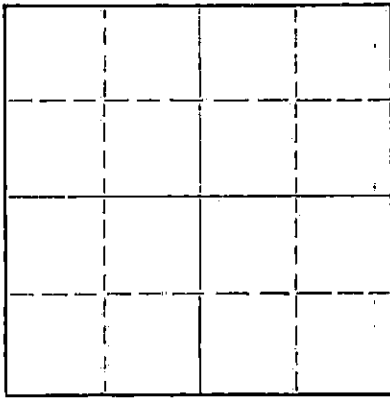


Give All Information Completely
Make Required Affidavit
Mail or Deliver Report to:
Conservation Division
State Corporation Commission
311 No. Broadway
Wichita, Kansas

WELL PLUGGING RECORD

NORTH

Locate well correctly on above
Section Plat

Hamilton County County. Sec. 20 Twp. 21S Rge. 42W (E) (W)
Location as "NE/CNW/SW" or footage from lines. SW/4 NE/4
Lease Owner Mack Oil Company
Lease Name Eubanks Unit Well No. 1
Office Address 812 Union Center
Character of Well (completed as Oil, Gas or Dry Hole) Dry Hole
Date well completed November 1 19 61
Application for plugging filed November 13 19 61
Application for plugging approved November 13 19 61
Plugging commenced December 6 19 61
Plugging completed December 7 19 61
Reason for abandonment of well or producing formation Dry Hole
If a producing well is abandoned, date of last production None 19
Was permission obtained from the Conservation Division or its agents before plugging was commenced? Yes

Name of Conservation Agent who supervised plugging of this well W. L. Lackamp, Jr.
Producing formation None Depth to top Bottom Total Depth of Well 3010 Feet
Show depth and thickness of all water, oil and gas formations.

OIL, GAS OR WATER RECORDS

CASING RECORD

FORMATION	CONTENT	FROM	TO	SIZE	PUT IN	PULLED OUT
Surface Sand & Gravel	Water	0	171	8 5/8	171	None
Permian Sand	Water	0	2930	4 1/2	2934	None

Describe in detail the manner in which the well was plugged, indicating where the mud fluid was placed and the method or methods used in introducing it into the hole. If cement or other plugs were used, state the character of same and depth placed, from feet to feet for each plug set.

DV tool in casing at 712'. Cemented with 75 sacks of Pozmix with 4% gel. Therefore, no pipe recovery. Bottom plug set at 2930'. Plugged at 190' with 10 sacks cement in 4 1/2" casing. Plugged at 35' with 3 sacks cement in 4 1/2" casing. Plugged at 10' with 2 sacks cement in 8 5/8" casing.

RECEIVED
STATE CORPORATION COMMISSION

DEC 13 1961

CONSERVATION DIVISION
Wichita, Kansas

12-18-61

(If additional description is necessary, use BACK of this sheet)

Name of Plugging Contractor Mack Oil Company
Address Box 471, Duncan, Oklahoma

STATE OF Kansas, COUNTY OF Sedgwick, ss.
Robert L. Harris (employee of owner) or (owner or operator) of the above-described well, being first duly sworn on oath, says: That I have knowledge of the facts, statements, and matters herein contained and the log of the above-described well as filed and that the same are true and correct. So help me God.

(Signature)

Robert L. Harris812 Union Center, Wichita, Kansas
(Address)SUBSCRIBED AND SWORN TO before me this 15th day of December, 19 61My commission expires September 8, 1963

Notary Public.



MACK OIL COMPANY
Duncan, Oklahoma

DRILLERS WELL LOG

Eubank Unit #1	C SW NE Sec. 20-21S-42W
Commenced R.D.: 9-2-61	Hamilton County, Kansas
Completed R.D.: 9-6-61	Elevation: 3768 K.B.
Total Depth: 3010'	Initial Production:
	Contractor: Mack Oil Company
Casing Record: 171' 8 5/8" O.D. Surface Casing	
2930' 4 1/2" Production Casing	

STRATA	DEPTH
Clay and post rock	0 - 35
Sand and shells	35 - 95
Shale	95 - 955
Shale and sand	955 - 995
Shale	995 - 1200
Shale and shells	1200 - 1570
Anhydrite and shale	1570 - 1687
Shale and shells	1687 - 1800
Shale	1800 - 2130
Anhydrite	2130 - 2335
Shale	2335 - 2355
Lime and shale	2355 - 2460
Shale	2460 - 2697
Lime and shale	2697 - 2857
Lime	2857 - 2920
Lime and shale	2920 - 3010

RECEIVED
STATE CORPORATION COMMISSION

NOV 13 1961

CONSERVATION DIVISION

I hereby certify that the above is a true and correct log of said well as reflected by the daily drilling reports.

MACK OIL COMPANY

By Robert L. Harris

Signed and sworn to in my presence this 13th day of November, 1961,
by Robert L. Harris, representative of Mack Oil Company.

Eudora Rae Barackman
Eudora Rae Barackman
Notary Public

My commission expires September 8, 1963.