


Give All Information Completely
Make Required Affidavit
Mail or Deliver Report to:
Conservation Division
State Corporation Commission
P. O. Box 17027
Wichita, Kansas 67217
NORTH

WELL PLUGGING RECORD

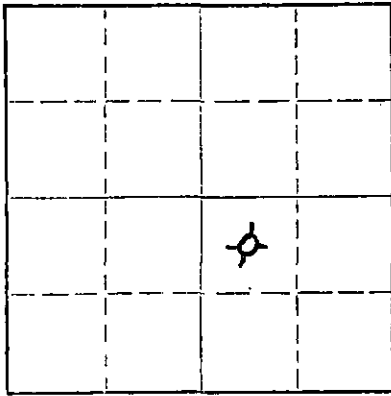

Locate well correctly on above
Section Plat

Hamilton County, Sec. 19 Twp. 21S Rge. 42W (E) (W)
Location as "NE/CNW&SW" or footage from lines C NW SE
Lease Owner Dare Gas Inc.
Lease Name Howell Well No. 1
Office Address Box 544 Liberal, Kansas 67901
Character of Well (completed as Oil, Gas or Dry Hole) Dry Hole
Date well completed 7-14 1973
Application for plugging filed 8-20 1973
Application for plugging approved 8-29 1973
Plugging commenced 9-20 1973
Plugging completed 9-21 1973
Reason for abandonment of well or producing formation
No Production Encountered
If a producing well is abandoned, date of last production 19
Was permission obtained from the Conservation Division or its agents before plugging was commenced? Yes

Name of Conservation Agent who supervised plugging of this well E. Eves
Producing formation None Depth to top Bottom Total Depth of Well 2850 Feet
Show depth and thickness of all water, oil and gas formations.

OIL, GAS OR WATER RECORDS

CASING RECORD

FORMATION	CONTENT	FROM	TO	SIZE	PUT IN	PULLED OUT
Surface	None	0	200	8-5/8	200	None
Permian	None	0	2850	4-1/2	2850	2314'

Describe in detail the manner in which the well was plugged, indicating where the mud fluid was placed and the method or methods used in introducing it into the hole. If cement or other plugs were used, state the character of same and depth placed, from feet to feet for each plug set.

Spot 15 Sacks @ 2610'
35 Sacks 600' - 500'
35 Sacks 200' - 100'
15 Sacks 45' - 0'


RECEIVED
STATE CORPORATION COMMISSION
OCT 4 1973
CONSERVATION DIVISION
Wichita, Kansas

(If additional description is necessary, use BACK of this sheet)

Name of Plugging Contractor Sargents Casing Pulling Service
Address Box 506 Liberal, Kansas 67901 License #511

STATE OF Kansas, COUNTY OF Seward, ss.
Ralph M. Reynolds (employee of owner) or (owner or operator) of the above-described well, being first duly sworn on oath, says: That I have knowledge of the facts, statements, and matters herein contained, and the log of the above-described well as filed, and that the same are true and correct. So help me God.

(Signature) Ralph M. Reynolds
Box 544 - Liberal, Kansas 67901
(Address)

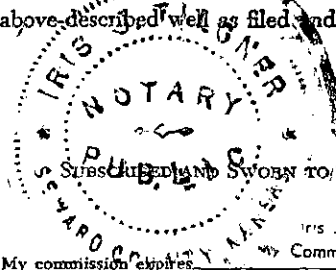

Subscribed and sworn to before me this 2 day of October, 1973
Iris J. Tilgner, Notary Public
My commission expires May 27, 1974
Iris J. Tilgner Notary Public.

LEASE: NOWELL #1
OWNER: DANE GAS OPERATING, INC.
CONY: EARL F. WARFIELD, INC.
COM: 7-4-73
COEP: 7-8-73

LOCATION: C SW NE
SECTION 19-21S-42W
HAMILTON COUNTY, KANSAS
CASING: 8 5/8" SET @ 201.57'
4 1/2" SET @ 2850'

Sand & Blue Shale	202
Blue Clay	260
Shale	1465
Shale - Shells	2135
Shale & Anhydrite	2410
Shale	2000
Lime	2850
R.T.D.	2850

STATE OF KANSAS)
) ss.
COUNTY OF SEDGWICK)

I, Gerald L. Mason, do hereby certify that this is a true and correct log on the Nowell #1, located C SW NE Section 19-21S-42W, Hamilton County, Kansas, as shown by the daily drilling reports.

EARL F. WARFIELD, INC.

By Gerald L. Mason
Gerald L. Mason

Subscribed and sworn to before me this 12th day of July, 1973.

My Commission Expires:
October 22, 1976

Carol Jean Noel
Carol Jean Noel - Notary Public

