


Give All Information Completely
Make Required Affidavit
Mail or Deliver Report to:
Conservation Division
State Corporation Commission
211 No. Broadway
Wichita, Kansas

WELL PLUGGING RECORD

NORTH

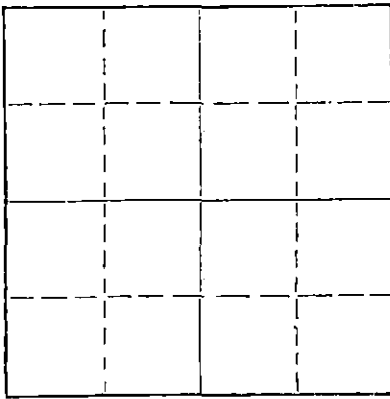

Locate well correctly on above
Section Plat

PAWNEE County, Sec. 31 Twp. 23S Rge. 16W (E) (W)

Location as "NE/CNWN&SWW" or footage from lines C SW SE

Lease Owner APACHE OIL COMPANY

Lease Name SCHARTZ Well No. 2

Office Address 823 SOUTH DETROIT, TULSA, OKLAHOMA

Character of Well (completed as Oil, Gas or Dry Hole) DRY HOLE

Date well completed June 14, 19 61

Application for plugging filed June 14, 19 61

Application for plugging approved June 14, 19 61

Plugging commenced June 14, 19 61

Plugging completed June 14, 19 61

Reason for abandonment of well or producing formation DRY HOLE

If a producing well is abandoned, date of last production _____ 19 _____

Was permission obtained from the Conservation Division or its agents before plugging was commenced? YES

Name of Conservation Agent who supervised plugging of this well FRANK BROADFOOT, 222 SO. MAIN, ST. JOHN, KANSAS

Producing formation _____ Depth to top _____ Bottom _____ Total Depth of Well 4518 Feet

Show depth and thickness of all water, oil and gas formations.

OIL, GAS OR WATER RECORDS

CASING RECORD

FORMATION	CONTENT	FROM	TO	SIZE	PUT IN	PULLED OUT
<u>Sand & Shale</u>	<u>Surface Csg.</u>	<u>-0-</u>	<u>237'</u>	<u>8-5/8"</u>	<u>237'</u>	<u>None</u>

Describe in detail the manner in which the well was plugged, indicating where the mud fluid was placed and the method or methods used in introducing it into the hole. If cement or other plugs were used, state the character of same and depth placed, from _____ feet to _____ feet for each plug set.

PLUGGED: Filled hole with heavy mud 4518' up to 225'.
Bridge using 1/4 sk. hulls, plug, 20 sx.
cement through drill pipe. Filled hole with
mud up to 35', 1/4 sk. hulls, wood plug, 10
sx. cement to cellar zero.

Job completed: 8 a.m. 6-14-61

RECEIVED
STATE CORPORATION COMMISSION

JUN 16 1961

6-16-61

CONSERVATION DIVISION
Wichita, Kansas

(If additional description is necessary, use BACK of this sheet)

Name of Plugging Contractor SIERRA PETROLEUM CO., INC.

Address 208 PETROLEUM BUILDING, WICHITA, KANSAS

STATE OF KANSAS, COUNTY OF RUSSELL, ss.

G. T. HONAKER, DRILLING SUPERINTENDENT (employee of owner) or (owner or operator) of the above-described well, being first duly sworn on oath, says: That I have knowledge of the facts, statements, and matters herein contained and the log of the above-described well as filed and that the same are true and correct. So help me God.

(Signature) G. T. Honaker G. T. HONAKER, DRIG. SUPT.

BOX 232, RUSSELL, KANSAS
(Address)

SUBSCRIBED AND SWORN to before me this 15th day of June, 19 61

Levey Drey
Notary Public.

My commission expires 10-17-63



15-145-19057-000

APACHE OIL COMPANY - Operator

SIERRA PETROLEUM CO., INC - Contractor

SCHARTZ #2
C SW SE
Sec. 31-23S-16W
Pawnee County, Kansas

T. D.: 4518'
Elev.: 2083' K.B.

RECEIVED
STATE CORPORATION COMMISSION

Commenced: 6-2-61
Completed: 6-14-61

JUN 16 1961

Casing:

CONSERVATION DIVISION
Wichita, Kansas

Cement

8-5/8" Set at 237'

with 160 sx. cement

FORMATION

DEPTH

Sand	90
Shale	440
Shale & Red Bed	560
Sand	620
Red Bed	1072
Anhydrite	1093
Shale & Shells	1370
Shale & Lime	1510
Shale & Salt	1685
Shale & Lime	3789
Lime	4075
Lime & Shale	4232
Mississippi	4285
Viola	4462
Simpson	4506
Arbuckle	4518

TOPS:

Anhydrite	1072
Mississippi	4192
Viola	4277
Arbuckle	4492

STATE OF KANSAS)
) ss:
COUNTY OF RUSSELL)

I hereby certify that the above information is true
and correct to the best of my knowledge.

A. T. Honaker

Subscribed and sworn to before me this 15th day of June
1961.

Geroy King
Notary Public

My commission expires: 10-17-63