


WELL PLUGGING RECORD

Give All Information Completely  
Make Required Affidavit  
Mail or Deliver Report to:  
Conservation Division  
State Corporation Commission  
211 No. Broadway  
Wichita, Kansas

Pawnee County. Sec 31 Twp 23 Rge. 16 (NE) (W)  
Location as "NE/CNW/SW" or footage from lines C SW NW  
Lease Owner Apache Oil Co. / Sierra Petro - Contractor  
Lease Name PTLIER Well No. 1  
Office Address Tulsa, Okla. / 208 Petr Bldg., Wichita, Kansas  
Character of Well (completed as Oil, Gas or Dry Hole) dry  
Date well completed 11/2/59 19  
Application for plugging filed 11/2/59 19  
Application for plugging approved 11/2/59 19  
Plugging commenced 11/2/59 19  
Plugging completed 11/2/59 19  
Reason for abandonment of well or producing formation dry

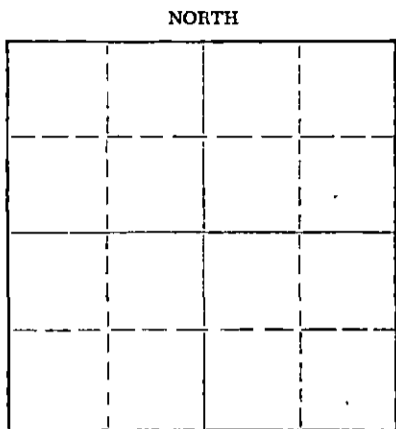

Locate well correctly on above Section Plat

If a producing well is abandoned, date of last production \_\_\_\_\_ 19\_\_\_\_  
Was permission obtained from the Conservation Division or its agents before plugging was commenced? yes

Name of Conservation Agent who supervised plugging of this well Mr. Eldon Petty, Hays, Kansas  
Producing formation \_\_\_\_\_ Depth to top \_\_\_\_\_ Bottom \_\_\_\_\_ Total Depth of Well 4522 Feet  
Show depth and thickness of all water, oil and gas formations.

OIL, GAS OR WATER RECORDS

CASING RECORD

FORMATION	CONTENT	FROM	TO	SIZE	PUT IN	PULLED OUT
				8 5/8	235	none

Describe in detail the manner in which the well was plugged, indicating where the mud fluid was placed and the method or methods used in introducing it into the hole. If cement or other plugs were used, state the character of same and depth placed, from \_\_\_\_\_ feet to \_\_\_\_\_ feet for each plug set.

PLUGGING REPORT

Filled hole with heavy mud from 4522 up to 500'. Set bridge using 1/3 sks hulls, wood plug and 20 sacks cement through drill pipe. Filled hole up to 210' with heavy mud, set bridge using 1/3 sks hulls, wood plug and 15 sks cement through drill pipe. Filled hole up to 40', set bridge using 1 sks hulls, wood plug and 10 sks cement to cellar 0.  
Job complete 6:00 pm 11/2/59

RECEIVED  
STATE CORPORATION COMMISSION  
NOV 4 1959  
CONSERVATION DIVISION  
Wichita, Kansas

(If additional description is necessary, use BACK of this sheet)  
Name of Plugging Contractor Sierra Petroleum Co., Inc.  
Address 208 Petroleum Bldg., Wichita, Kansas

STATE OF KANSAS COUNTY OF RUSSELL, ss.  
C. T. Honaker (employee of owner) or (owner or operator) of the above-described well, being first duly sworn on oath, says: That I have knowledge of the facts, statements, and matters herein contained and the log of the above-described well as filed and that the same are true and correct. So help me God.

(Signature) C. T. Honaker

(Address) \_\_\_\_\_

SUBSCRIBED AND SWORN TO before me this 3rd day of November, 19 59

Margie Cooper  
Notary Public.

My commission expires 1-30-61.



15-145-19056-000

Apache Oil Co - Owner

Sierra Petroleum Co - Contractor

PIILER #1

C SW NW Sec 31-23-16  
Pawnee County, Kansas

Total Depth: 4522

Elev: 2079 KB

Commi 10/20/59  
Comp: 11/2/59

Casing:  
3 5/8 @ 235'

Cement:  
with 175 sacks cement

FORMATION	DEPTH
Surface Clay	20
Sand & Gravel	85
Shale & shells	370
Red Bed	555
Sand	620
Red Bed	1070
Anhydrite	1090
Shale & shells	1965
Lime & shale	3549
Lime	3740
Lime & shale	3798
Lime	4070
Lime & shale	4216
Kinderhook	4257
Viola	4522
Tops:	
Anhydrite	1070
Heebner	3633
Toronto	3651
Lans K. C.	3760
Mississippi	4189
Viola	4257
Simpson Shale	4457
Simpson Sand	4484

STATE OF KANSAS     )  
                          ) ss:  
COUNTY OF RUSSELL )

I hereby certify that the above information is true and correct to the best of my knowledge.

C. T. Honaker

Subscribed and sworn to before me this 3rd day of November, 1959.

Margie Cooper  
Notary Public

My commission expires: 1-30-61.

RECEIVED  
STATE CORPORATION COMMISSION  
NOV 4 1959  
CONSERVATION DIVISION  
Wichita, Kansas