


15-145-20173-000

STATE OF KANSAS  
STATE CORPORATION COMMISSION  
CONSERVATION DIVISION  
P. O. BOX 17027  
WICHITA, KANSAS 67217

WELL PLUGGING RECORD

Pawnee County, Sec. 32 Twp. 23 Rge. (E) 16 (W)

Location as "NE/CNW&SW&" or footage from lines NW SE NW  
Lease Owner Leben Oil Corporation  
Lease Name Hammeke Well No. 1  
Office Address 4120 East 51st Street, Tulsa, Okla. 74135  
Character of Well (completed as Oil, Gas or Dry Hole) gas  
Date well completed Oct. 25 19 70  
Application for plugging filed Aug. 14 19 75  
Application for plugging approved \_\_\_\_\_ 19 \_\_\_\_\_  
Plugging commenced Aug. 21 19 75  
Plugging completed Sept. 2 19 75  
Reason for abandonment of well or producing formation depleted

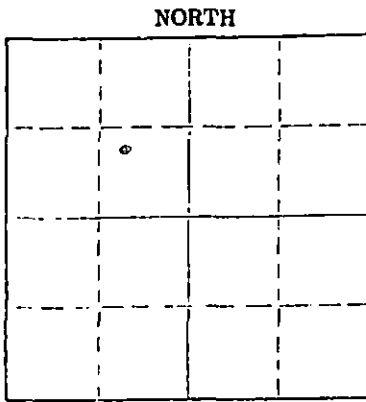

Locate well correctly on above Section Plot

If a producing well is abandoned, date of last production \_\_\_\_\_ 19 \_\_\_\_\_  
Was permission obtained from the Conservation Division or its agents before plugging was commenced? yes

Name of Conservation Agent who supervised plugging of this well Leo Massey  
Producing formation \_\_\_\_\_ Depth to top \_\_\_\_\_ Bottom \_\_\_\_\_ Total Depth of Well 4303 feet  
Show depth and thickness of all water, oil and gas formations.

OIL, GAS OR WATER RECORDS

CASING RECORD

FORMATION	CONTENT	FROM	TO	SIZE	PUT IN	PULLED OUT
			250'	8 5/8"	250'	none
			4290'	4 1/2"	4290'	1985.04

Describe in detail the manner in which the well was plugged, indicating where the mud fluid was placed and the method or methods used in introducing it into the hole. If cement or other plugs were used, state the character of same and depth placed, from \_\_\_\_\_ feet to \_\_\_\_\_ feet for each plug set.

Set plug at 3975'. Sanded back to 3875' and dumped 4 sacks of cement.

Sun Cementing Company plugged well pumping in 3 sacks of hulls, 25 sacks of gel, 1 plug and 125 sacks of cement.

(If additional description is necessary, use BACK of this sheet)  
Name of Plugging Contractor PIPE PULLERS, INC.  
Address Box 128, Ellinwood, Kansas 67526

STATE OF KANSAS COUNTY OF BARTON ss.  
Evelyn Roth (employee of owner) or (owner-operator) of the above-described well, being first duly sworn on oath, says: That I have knowledge of the facts, statements, and matters herein contained and the log of the above-described well as filed and that the same are true and correct. So help me God.

(Signature) Evelyn Roth  
Ellinwood, Kansas (Address)

SUBSCRIBED AND SWORN TO before me this 5th day of September, 19 75

My commission expires \_\_\_\_\_  
**JENNY KASSELMAN**  
NOTARY PUBLIC  
BARTON COUNTY, KANSAS  
MY COMM. EXP. JULY 16, 1978

Jenny Kaselman  
Notary Public.

WELL LOG

15-145-20173-0000

Company Leben Drilling, Inc.

Sec. 32 T. 23S R.16W

Contractor Leben Drilling, Inc.

Loc. NW SE NW

Farm Hammeke #1

County Pawnee

Total Depth 4303' RTD

Casing 8 5/8" 20# New casing set @ 250' w/250 sxs. Common 2% C.C.

Commenced 10-16-70

Production

Completed 10-25-70

Producer


Figures Indicate Bottom of Formations

60	Sand
170	Shale & Sand
285	Shale
558	Shale & Red Bed
604	Sand
1064	Shale & Red Bed
1088	Anhydrite
1906	Shale & Shells
3770	Lime & Shale
3925	Lime
4005	Lime & Shale
4165	Lime
4192	Lime & Chert
4297	Lime & Shale
4303	Lime
<u>4303</u>	<u>RTD</u>

RECEIVED  
STATE CORPORATION COMMISSION  
AUG 15 1975  
CONSERVATION DIVISION  
Wichita, Kansas

State of Kansas }  
} SS  
County of Barton

I, James R. Rodgers of Leben Drilling, Inc., upon oath state that the above and foregoing is a true and correct copy of the log of the Hammeke #1 Well.



James R. Rodgers

Subscribed and sworn to before me this 30th day of October, 1970

My Commission Expires:  
November 13, 1973

Helen L. Lindenmuth