


STATE OF KANSAS
STATE CORPORATION COMMISSION

WELL PLUGGING RECORD

15-445-20171-0001

Give All Information Completely
Make Required Affidavit
Mail or Deliver Report to
Conservation Division
State Corporation Comm.
245 North Water
Wichita, KS 67202

Pawnee County, Sec. 32 Twp. 23 Rge. 16 E/W
Location as "NE/CNW $\frac{1}{4}$ SW $\frac{1}{4}$ " or footage from lines _____
C E/2 SE/4
Lease Owner Sterling Drilling Company
Lease Name Wurm #2 Well No. _____
Office Address Sterling, Kansas 67579
Character of Well (Completed as Oil, Gas or Dry Hole) _____

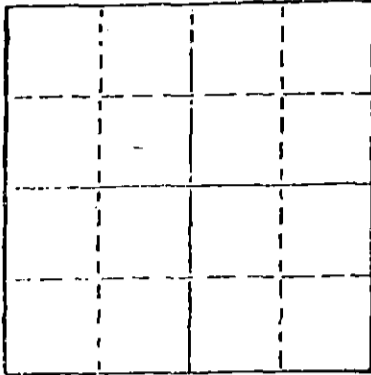

Locate well correctly on above Section Plat

Date Well completed _____ 19____
Application for plugging filed _____ 19____
Application for plugging approved _____ 19____
Plugging commenced 7/5/77 _____ 19____
Plugging completed 7/8/77 _____ 19____
Reason for abandonment of well or producing formation _____
depleted.
If a producing well is abandoned, date of last production _____ 19____

Was permission obtained from the Conservation Division or its agents before plugging was commenced? yes _____

Name of Conservation Agent who supervised plugging of this well Massey
Producing formation _____ Depth to top _____ Bottom _____ Total Depth of Well 2931
Show depth and thickness of all water, oil and gas formations.

OIL, GAS OR WATER RECORDS

CASING RECORD

FORMATION	CONTENT	FROM	TO	SIZE	PUT IN	PULLED OUT
				8-5/8	317	none
				4 1/2"	2889	1903

Describe in detail the manner in which the well was plugged, indicating where the mud fluid was placed and the method or methods used in introducing it into the hold. If cement or other plugs were used, state the character of same and depth placed, from _____ feet to _____ feet for each plug set.

Checked hole, sanded to 2150' and ran 3 sacks cement. Shot pipe at 2002', 1900', pulled 57 joints. Pumped 1 sack bulls, 20 sacks gel, plug and 120 sacks cement, 60-40 poz.

PLUGGING COMPLETE.

RECEIVED
STATE CORPORATION COMMISSION
JUL 14 1977

(If additional description is necessary, use back of this sheet)
Name of Plugging Contractor KESLO CASING PULLING
CHASE, KANSAS


STATE OF KANSAS COUNTY OF RICE, ss.
R. DARRELL KELSO (employee of owner) or (owner or operator)
of the above-described well, being first duly sworn on oath, says: That I have knowledge of the facts, statements, and matters herein contained and the log of the above-described well as filed and that the same are true and correct. So help me God.

(Signature) R. Darrell Kelso
CHASE, KANSAS
(Address)

SUBSCRIBED AND SWORN TO before me this 13th day of July, 19 77

Margaret Melcher
Notary Public.

My commission expires

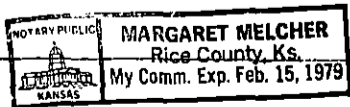

B-145-20171-0001

OWWO

STATE	KANSAS	9-1-30	MAP NO.	S-T-R	32-23S-16W	WSX
OPER	STERLING DRIG			SPOT	C E2 SE	INIT
	BOX 129, STERLING, KS 67579			CO	PAWNEE	WS
WELL	2 WURM			ELEV	Old KB 2077	FIN
CONTR	OWN					
FIELD	CARPENTER(MULTIPAY)					
IP	D & A					
	API 15-145-20171-0001					

Old Info: Was Imperial Oil, 1 Wurm, SPUD 10-13-70, OTD 4436
WAS D & A, COMPLETED 10-24-70
New Info: Re-entered 6-27-76, CO to 2900, log 4 1/2" @ 2889 w/100
 Perf(TARKIO) 6/2783-85, Swbd Wtr, NSG, Perf (RED EAGLE) 6/2729-31, Swbd Wtr, NSG, FU 700' SW/ 14 hrs, Perf(CW) 2604-05, 2607-09, Tstd Wtr, Perf(FR) 2288-90, 250 GA, No fluid, Perf(WIN) 2176-82, tstd wtr
D & A, COMPLETED 8-16-76

OLD LOG TOPS:
 LANSING 3750 - 1673
 ARBUCKLE 4424 - 2347
 OTD 4436 - 2359
 NEW KB LOG TOPS:
 WINFIELD 2171 - 94
 FORT RILEY 2287 - 210
 COTTONWOOD 2601 - 524
 RED EAGLE 2727 - 650
 TARKIO 2783 - 706
 RTD 2900 - 823
 TD IN TARKIO
 COMP ISSUED 9-7-76

 Petroleum Information
COMPANIES
 COPYRIGHTED 1976. REPRODUCTION PROHIBITED

RECEIVED
 STATE CORPORATION COMMISSION
 JUN 20 1977
 CONSERVATION DIVISION
 Topeka, Kansas

revised 9-23-76