


WELL PLUGGING RECORD

Give All Information Completely
Make Required Affidavit
Mail or Deliver Report to:
Conservation Division
State Corporation Commission
800 Biting Building
Wichita, Kansas

Pawnee County. Sec. 32 Twp. 23 Rge. 16 (X) (W)
Location as "NE/CNWxSWx" or footage from lines SW SW SW
Lease Owner Petroleum Management, Inc. & D & M Drilling Co., Inc.
Lease Name A. WURM Well No. 1
Office Address 810 Central Building, Wichita 2, Kansas
Character of Well (completed as Oil, Gas or Dry Hole) Dry
Date well completed 4-8-1955
Application for plugging filed 5-16-1955
Application for plugging approved 5-17-1955
Plugging commenced 5-18-1955
Plugging completed 5-27-1955
Reason for abandonment of well or producing formation Dry & Abandoned
If a producing well is abandoned, date of last production 19
Was permission obtained from the Conservation Division or its agents before plugging was commenced? Yes

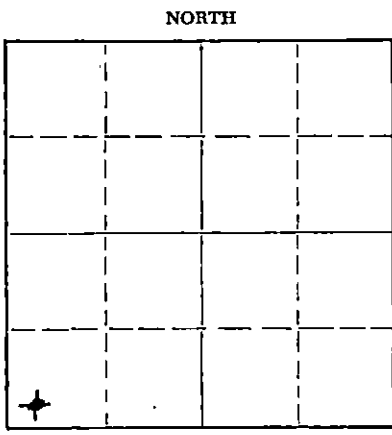

Locate well correctly on above Section Plat

Name of Conservation Agent who supervised plugging of this well W. H. Horner
Producing formation Mississippi Depth to top 4253 Bottom 4369 Total Depth of Well 4595 Feet
Show depth and thickness of all water, oil and gas formations.

OIL, GAS OR WATER RECORDS

CASING RECORD

FORMATION	CONTENT	FROM	TO	SIZE	PUT IN	PULLED OUT
Heebner		3667	3692	5 7/8" O.D.		
Brown Lime		3692	3803	"		
Lansing -K.C.		3803	4082	"		
Mississippi		4253	4369	"		
Maquoketa		4369	4378	"		
Viola		4378	4509	"		
Simpson		4509	4565	"		
Arbuckle		4565	4595	"		2900'

Describe in detail the manner in which the well was plugged, indicating where the mud fluid was placed and the method or methods used in introducing it into the hole. If cement or other plugs were used, state the character of same and depth placed, from _____ feet to _____ feet for each plug set.

Dumped chat 4250' to 4300' and 5 sacks cement at 4250'. Pulled 5 7/8" casing.

Pumped 15 sacks mud and 85 sacks cement in 8 5/8" O.D. Surface Casing.

NOTE:

This well was tested in the Mississippi formation. Oil in commercial quantities was not obtainable.

RECEIVED
STATE CORPORATION COMMISSION
JUN 4 - 1955
CONSERVATION DIVISION
Wichita, Kansas

(If additional description is necessary, use BACK of this sheet)

Name of Plugging Contractor Morgan Well Plugging Service
Address Hutchinson, Kansas

STATE OF Kansas COUNTY OF Sedgwick, ss.
John W. Ritchey (employee of owner) or (owner or operator) of the above-described well, being first duly sworn on oath, says: That I have knowledge of the facts, statements, and matters herein contained and the log of the above-described well as filed and that the same are true and correct. So help me God.

(Signature) _____
810 Central Building, Wichita 2, Kansas
(Address)

SUBSCRIBED AND SWORN TO before me this 3rd day of June, 19 55

My commission expires April 23, 1958

Maree C. Murphy
Notary Public.

PLUGGING
FILE SEC 32 Twp. 23 R. 16
BOOK PAGE 119 LINE 19

54 SW SW of Section 32-238-16W Pawnee County, Kansas

Rigged up Rotary Tools 3/7/55

Run 9 Jts (190') 5/8" Surface pipe (used) 2 1/2", set at 100'. Cemented with 125 sacks bulk cement, 2 1/2 Gal. Oil.

Tore down Rotary Tools 3/20/55

Run 137 Jts. (1264.92') 5 1/2" Dia. Casing set at 4364'. Cemented with 150 sacks bulk cement.

FORMATION	FROM	TO	TOBS
Sand & shells	0'	70'	Nehmer . . . 3687 - 1574
Sand & shale	70	120	Top KC . . . 3003 - 1570
Shale & shells	120	200	Bottom KC . . 4081 - 1942
Gray shale	190	400	High 4757 - 2260
Bedded	400	1055	Viola 4777 - 2265
Anhydrite	1055	1095	Simpson . . . 4507 - 2416
Shale & shells	1095	1710	Arbuckle . . . 4545 - 2472
Lime streaks & shale	1710	2405	
Shale & lime	2405	2570	
Lime & shale streaks	2570	2617	
Lime & shale	2617	3515	
Lime & shale streaks	3515	3586	
Lime & shale	3586	3772	
Lime & shale streaks	3772	3869	
Lime	3869	4081	
Shale & lime streaks	4081	4110	
Lime & shale	4110	4190	
Conglomerate	4190	4253	
Mississippi Chert	4253	4300	
Chert, shale & sand	4300	4321	
Shale	4321	4324	
Sand	4324	4340	
Sand, shale & chert	4340	4412	
Viola	4412	4445	
Shale & chert	4445	4460	
Lime, shale & chert	4460	4550	
Shale & lime	4550	4565	
Arbuckle Lime	4565	4595	ED

RECEIVED
STATE CORPORATION COMMISSION
JUN 4 - 1955
CONSERVATION DIVISION
Wichita, Kansas

I, E. R. Barnett, do hereby certify that the foregoing log is true and correct, to the best of my knowledge and belief.

E. R. Barnett

Subscribed and sworn to before me this 21st day of March, 1955

[Signature]

My commission expires: July 27, 1957

PLUGGING
WEL SEC 32-238-16W
BOOK PAGE 119 LINE 19