

WELL PLUGGING RECORD

Give Information Completely  
Make Required Affidavit  
Mail or Deliver Report to:  
Conservation Division  
State Corporation Commission  
800 Bittling Building  
Wichita, Kansas

Pawnee

County. Sec. 34 Twp. 23 Rge. 16 (E) W (W)

Location as "NE/CNW $\frac{1}{4}$ SW $\frac{1}{4}$ " or footage from lines NW/4 NW/4 NE/4

Lease Owner Transit Corporation & Davis Brothers

Lease Name Wurm Well No. 1

Office Address 1516 Liberty Bank Bldg., Okla. City, Okla.

Character of Well (completed as Oil, Gas or Dry Hole) Dry Hole

Date well completed 6-3 19-52

Application for plugging filed 6-3 19-52

Application for plugging approved 6-3 19-52


Plugging commenced 6-3 19-52

Plugging completed 6-3 19-52

Reason for abandonment of well or producing formation

If a producing well is abandoned, date of last production 19

Was permission obtained from the Conservation Division or its agents before plugging was commenced? Yes

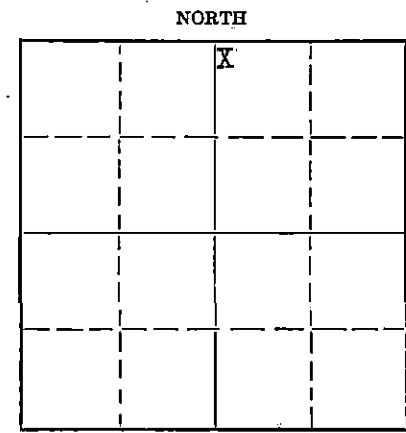

Locate well correctly on above Section Plat

Name of Conservation Agent who supervised plugging of this well M. A. Rives, Box 118, Pratt, Kansas

Producing formation Depth to top Bottom Total Depth of Well 4220 Feet

Show depth and thickness of all water, oil and gas formations:

OIL, GAS OR WATER RECORDS

CASING RECORD

Formation	Content	From	To	Size	Put In	Pulled Out
				8-5/8	368'	None

Describe in detail the manner in which the well was plugged, indicating where the mud fluid was placed and the method or methods used in introducing it into the hole. If cement or other plugs were used, state the character of same and depth placed, from feet to feet for each plug set.

Filled Hole with heavy drilling mud to 300', set plug and cemented with 20 sacks cement. Filled hole with heavy drilling mud to 30', set plug and cemented with 10 sacks cement to bottom of cellar.

(If additional description is necessary, use BACK of this sheet)

Name of Plugging Contractor Transit Corporation

Address 1516 Liberty Bank Bldg., Okla. City, Okla.

STATE OF Oklahoma, COUNTY OF Oklahoma, ss.

L. J. Kruse (employee of owner) or (owner/representative) of the above-described well, being first duly sworn on oath, says: That I have knowledge of the facts, statements, and matters herein contained and the log of the above-described well as filed and that the same are true and correct. So help me God.

(Signature) *L. J. Kruse*

Oklahoma City, Okla. (Address)

SUBSCRIBED AND SWORN to before me this 10th day of June, 1952

My commission expires October 24, 1955

23-8390-s 6-51-20M

PLUGGING  
FILE NO. 34-23R-160  
BOOK PAGE 21 LINE 3

Notary Public.  
Lillian M. ...  
STATE CORPORATION COMMISSION  
6-11-52

TRANSIT CORPORATION & DAVIS BROS.

15-145-60018-0000

NW/4 NW/4 NE/4 Sec. 34-23S-16W  
Pawnee County, Kansas

WURM NO. 1

FORMATIONS	FROM	TO	REMARKS
Surface Sand & Clay	0	40	
Sand	40	95	
Shale & Shells	95	280	
Sand	280	305	8-5/8" C.S.A. @ 342'. Cemented
Shale & Shells	305	500	with 20 sacks cement.
Sand	500	560	
Shale & Shells	560	1010	
Anhydrite	1010	1040	
Shale & Shells	1040	1110	
Shale	1110	1145	
Shale & Shells	1145	1250	
Red Bed	1250	1400	
Sandy Lime	1400	1590	
Shale, Lime & Shells	1590	1900	
Lime	1900	2153	
Lime & Shale	2153	2255	
Lime	2255	2345	
Lime & Shale	2345	2465	
Lime	2465	2570	
Shale & Lime	2570	3150	
Lime	3150	3180	
Broken Lime & Shale	3180	3280	
Lime & Shale	3280	3680	
Lime	3680	4098	
Lime & Chert	4098	4130	
Conglomerate	4130	4166	
Arbuckle Lime	4166	4220	
Total Depth		4220'	

I hereby certify the foregoing to be a true and accurate Driller's Log of the formations encountered in the above well.

TRANSIT CORPORATION

**PLUGGING**  
FILE SEC 24-23-16W  
BOOK PAGE 21 LINE 3

*L. J. Kruse*  
L. J. Kruse  
Ass't Secretary

**RECEIVED**  
STATE CORPORATION COMMISSION  
JUN 14 1952

Subscribed and sworn to before me this 9th day of June, 1952.

My Commission Expires: October 24, 1955

*Walter W. Wright*  
Notary Public  
Wichita, Kansas  
CONSERVATION DIVISION  
Wichita, Kansas